


T. 9 S. R. 27 E. W.M. .

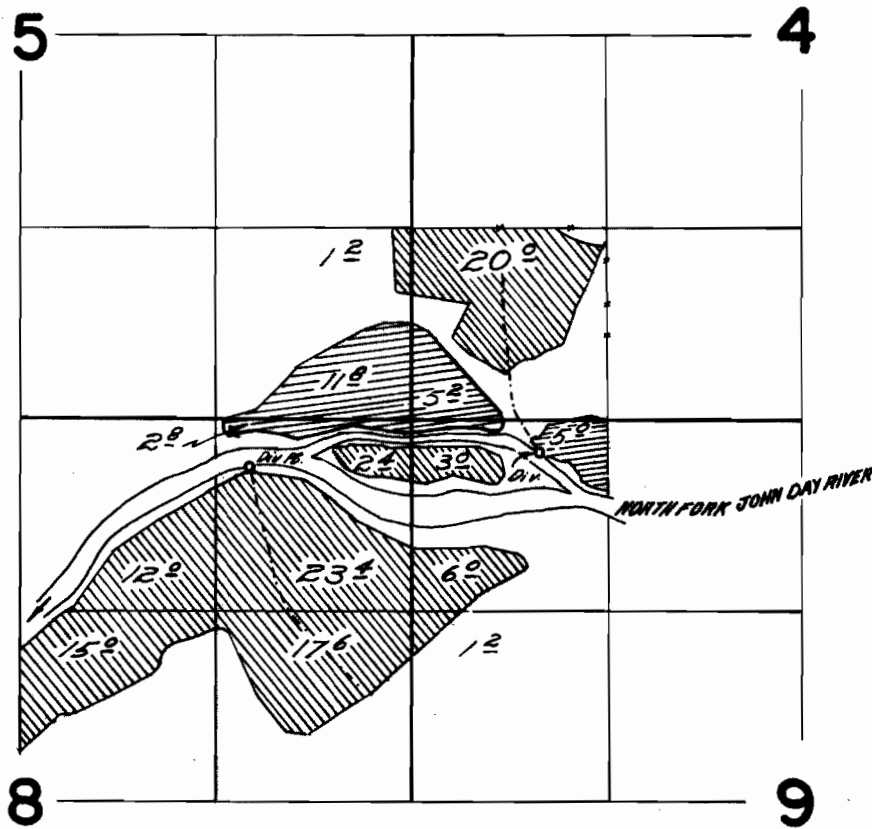

DIVERSION POINTS LOCATED 1650 FT. S. & 2450 FT. W.; &
 1450 FT. S. & 470 FT. W.; BOTH FROM N.E. CORNER
 SW 1/4 SW 1/4 SECTION 4.

 TRANSFER C-128

PERMIT 26207 

FINAL PROOF SURVEY UNDER


TRANSFER C-128

Application No. 33138.. Permit No. 26207
 IN NAME OF

W. & E. MILLER RANCHES, INC.

Surveyed July 10, 1964, by George M. Wood
 May 15, 1968 by W. d. Ruppert

T.9S.R.27E.W.M.

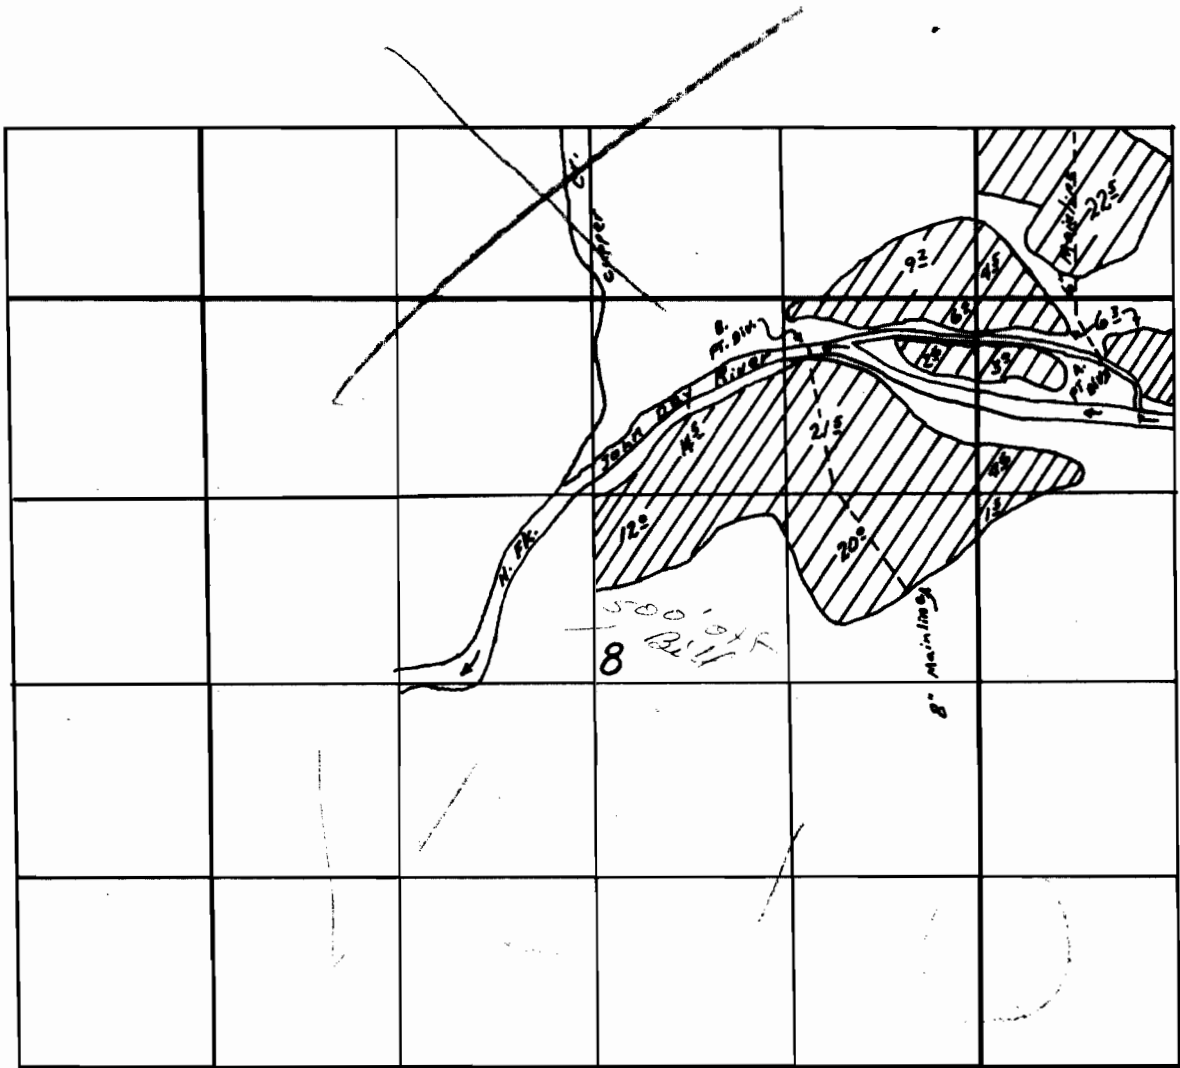

FINAL PROOF SURVEY
UNDER

Application No. 33132 Permit No. 26207
IN NAME OF

.....*Harold H. Cork*.....

Surveyed July 10, 1964, by *G. Ward*