


# T. 23 S., R. 8 W., W.M.

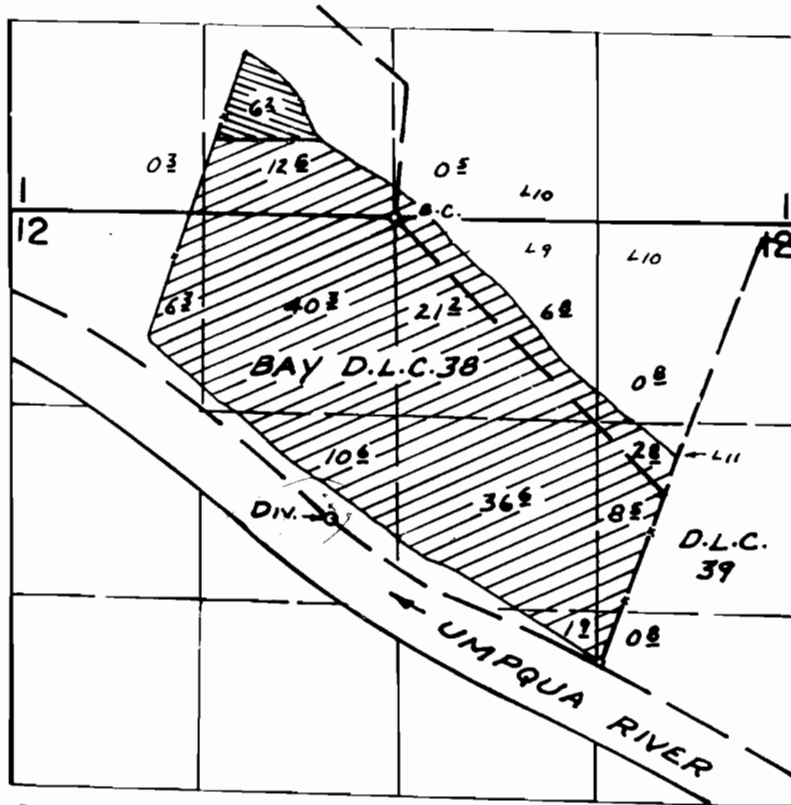

DIV. LOC: 2080' S. & 450' W. FROM N  $\frac{1}{4}$  COR. SEC. 12



PERMIT 43227



CERTIFICATE 46054

SCALE: 1" = 1,320'

## FINAL PROOF SURVEY

UNDER

Application No. 57622 Permit No. 43227  
IN NAME OF

CHARLES A. & VIRGIL K. KESTERSON

Surveyed SEPT. 14, 1990, by K. KEMP

