
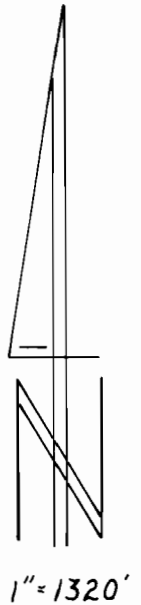


T. 2 S., R. 1 W., W.M.

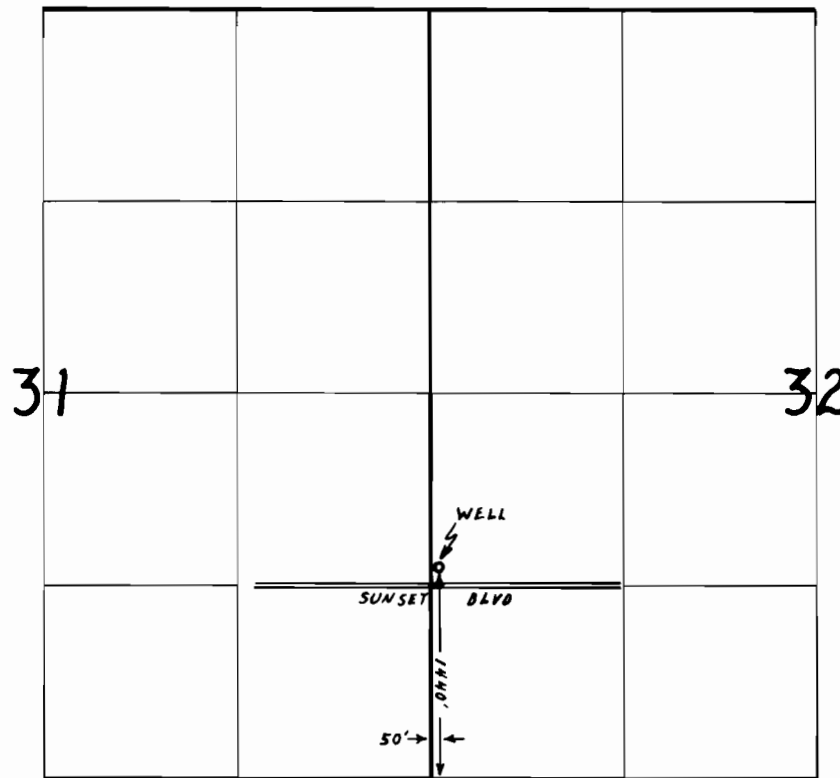

FINAL PROOF SURVEY

UNDER

Application No. G-11347 Permit No. G-10495
IN NAME OF

CITY OF SHERWOOD

Surveyed July 14, 1993, by R.W. Klassen