


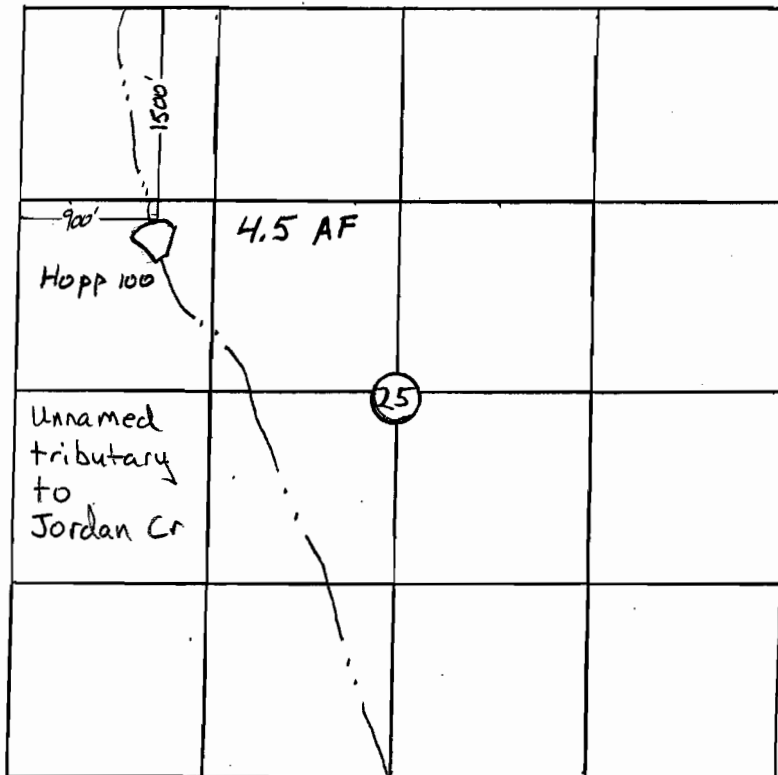

Scale
1"=1320'

T3S R36E



Max Height of Dam = 16 Feet
Max storage = 4.5 acre-Feet

FINAL PROOF SURVEY UNDER

Application No. R-85463 Permit No. R-13614
IN NAME OF

Carl Hopp JR.;

Surveyed 19....., by

RECEIVED

AUG 31 2006

WATER RESOURCES DEPT.
SALEM, OREGON