
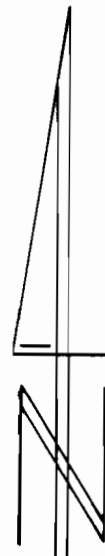


T. 5 S., R. 11 W., W.M.

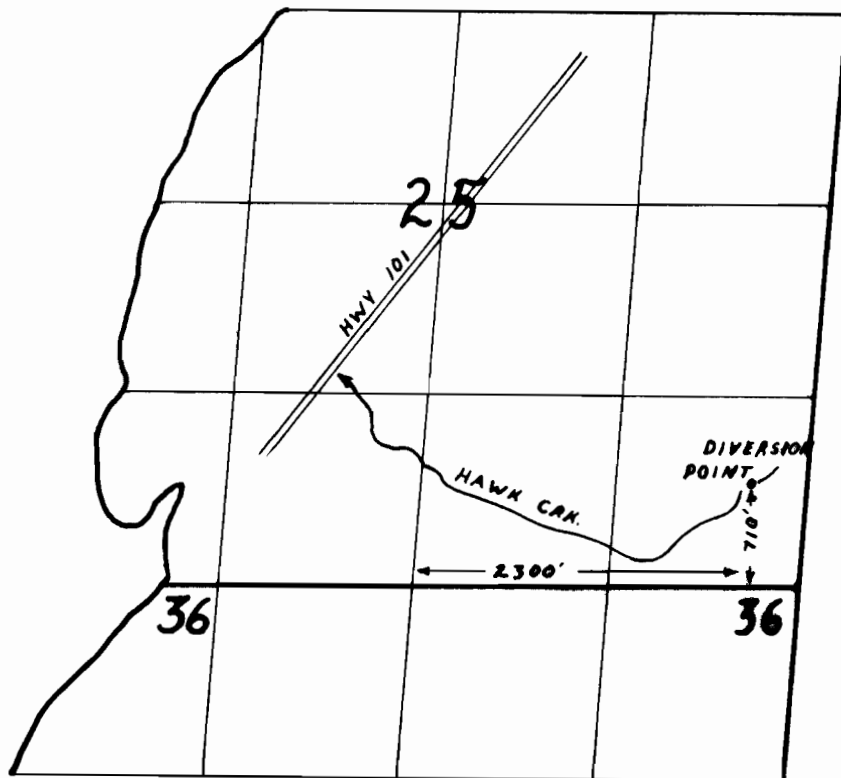

1" = 1320'

FINAL PROOF SURVEY

UNDER

Transfer No. 5929

IN NAME OF

Neskowin Regional Water District

Surveyed November 8, 1993, by R.W. Klassen