




T. 8 & 9 S., R. 25 E., W.M.

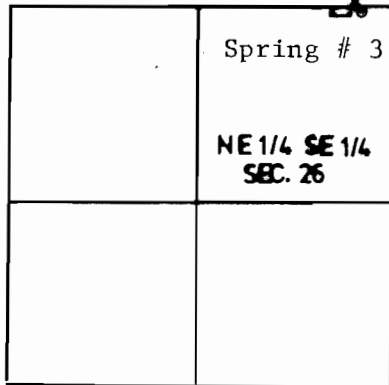

Spring # 3 - POD
2640' N. & 250' W. from
SE Cor. Sec. 26.
T 8 S, R 25 E.

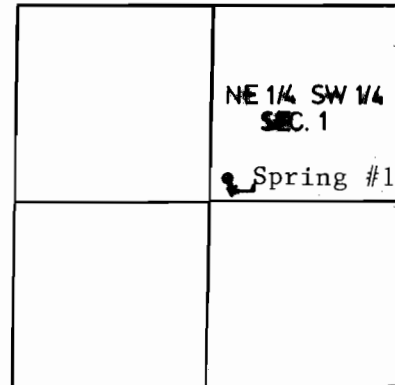

Spring # 1 - POD
150' N. & 100' E. from
SW Cor. of NE 1/4 SW 1/4,
Sec. 1.
T 9 S, R 25 E.

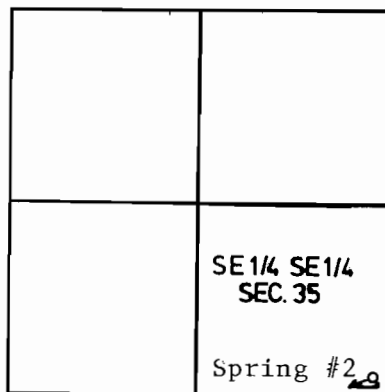

Spring # 2 - POD
110' N. & 50' W. from
SE Cor. Sec 35, T 8 S, R 25 E.



1" = 1320'

STOCK
TROUGH

FINAL PROOF SURVEY UNDER

Application No. 68811 Permit No. 49858
IN NAME OF

ROBERT W. STRAUB

Surveyed 10-16, 1992, by L. MILLER