

23920

T. 3 S., R. 1 E., W.M.



FINAL PROOF SURVEY

UNDER

23920 18840

Application No. 27051 Permit No. 21220

IN NAME OF


CARLETON PARISH FYNN, M. D.

DR. SAMUEL A. & MARGARET M. BRANDON

Surveyed July 29 1953, by H. L. Coffman

DFK-3D-54

T3S, R1E, WM

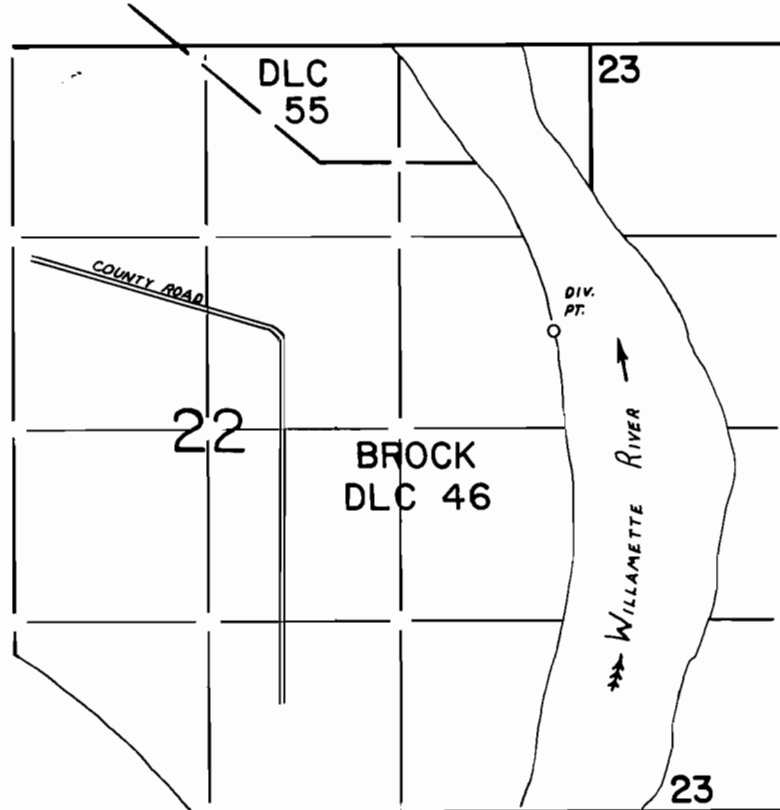

DIV. PT. LOCATED: 3340 FT N & 2325 E FROM S 1/4 CORNER SECTION 22

FINAL PROOF SURVEY UNDER

Transfer No.5823.....
 Application No. Permit No.
 IN NAME OF

.....GARNET PANKEY.....

Surveyed JULY...22.. 1987., by T.M. WARREN.....