


T.4N.R.IOW.W.M.

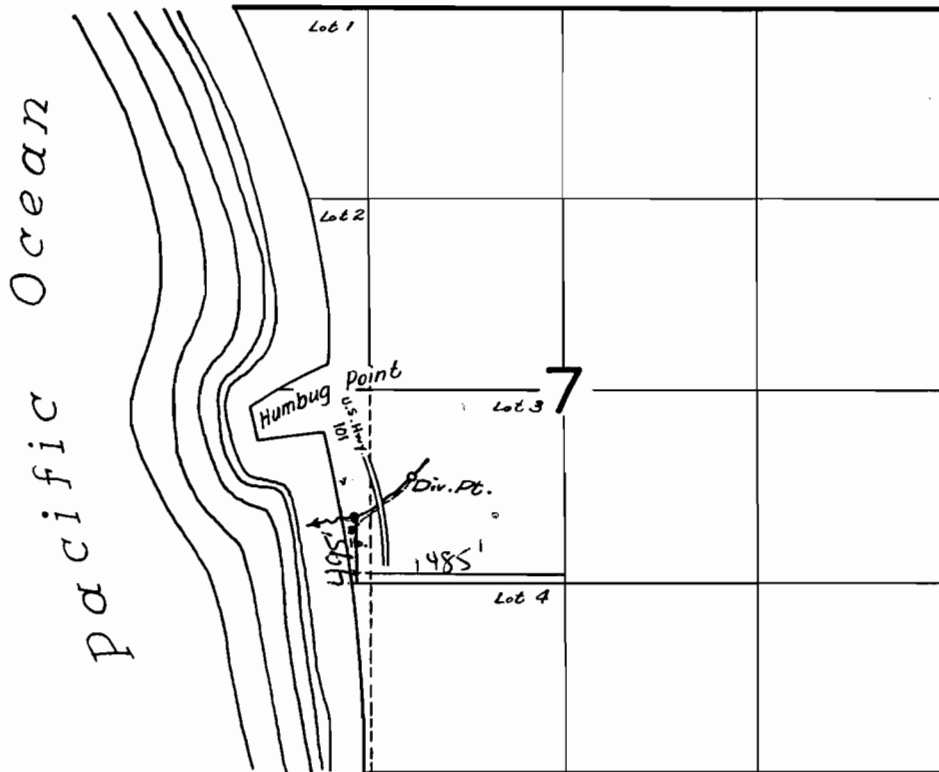

DIV PT: 495' N & 1485' W, SE CORNER, LOT 3

Per Inspection Report, 6/22/89

FINAL PROOF SURVEY
UNDER

Application No. **32664** Permit No. **25794**
IN NAME OF

KEITH R. & MARY E. MECKLEM

Surveyed July 10, 1962, by

[Signature]