
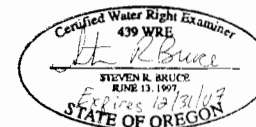
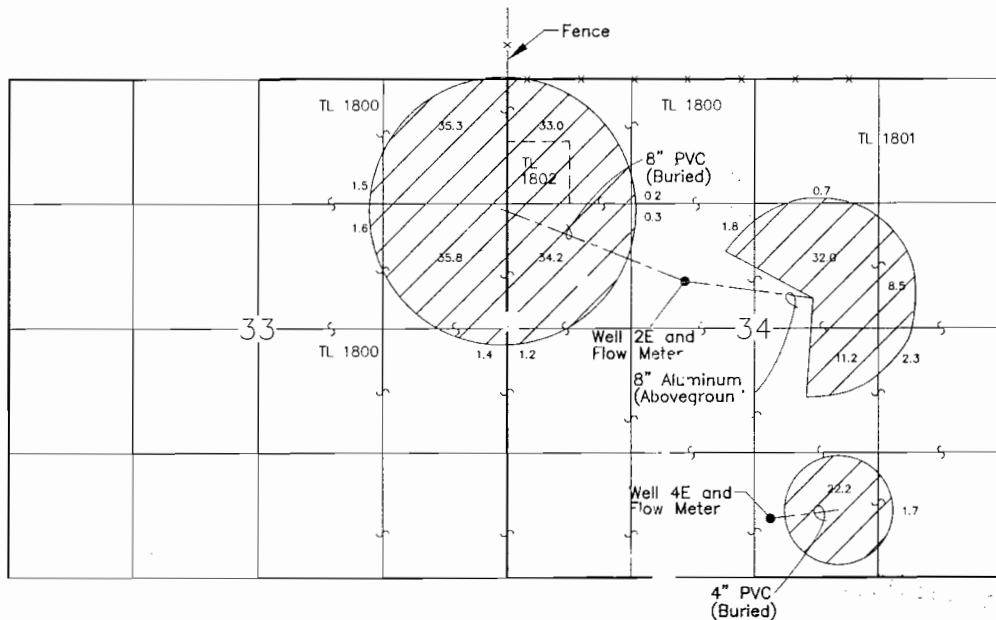


T148, R14E, W.M.
SECTIONS 33 AND 34
CROOK COUNTY

APPLICATION G-14365,
PERMIT G-13237 AND T-8849

MARTIN TISTHAMMER

1 INCH = 1320 FEET

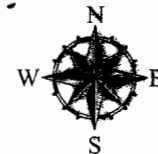

Legend

- Well Location
- ▨ Place of Use (224.9 acres)

RECEIVED

MAR 23 2006

WATER RESOURCES DEPT
SALEM OREGON

COBU MAP # 0210

NOTES:

1. Well 2E located 2,140 feet south and 1,900 feet east of northwest corner of section 34.
2. Well 4E located 620 feet north and 2,810 feet east of southwest corner of section 34.
3. Survey completed on 8/29/05.
4. This map supersedes Claim of Beneficial Use Map dated 09/21/05.

Revised Claim of Beneficial Use Map

Martin Tisthammer
Powell Butte, Oregon

GEOENGINEERS

Figure 1

THIS MAP IS NOT INTENDED TO PROVIDE LEGAL DIMENSIONS OR LOCATIONS OF PROPERTY OWNERSHIP LINES.