


T.1N.R.26 E.W.M.

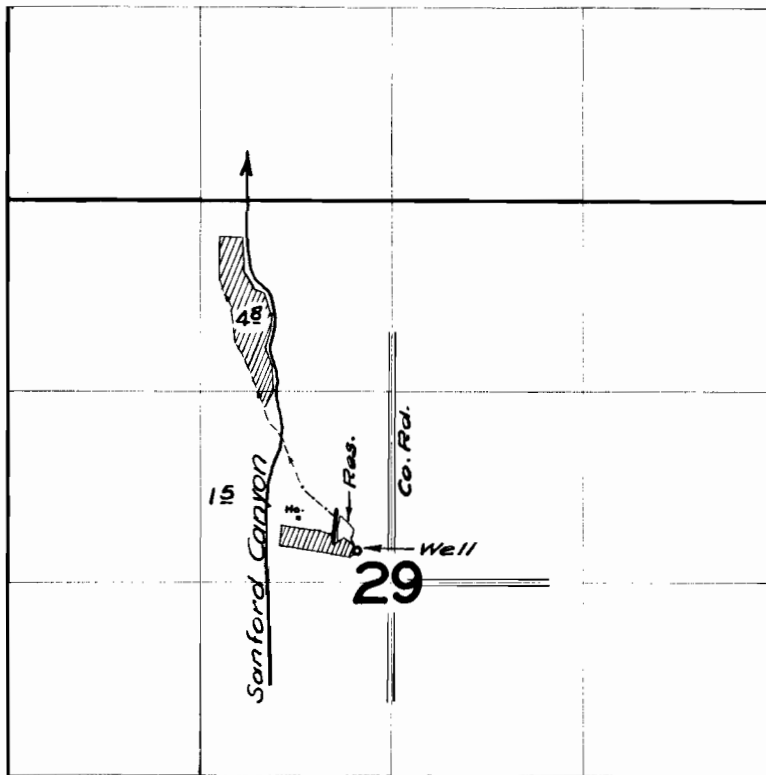

FINAL PROOF SURVEY
UNDER

Application No. U-546 Permit No. U-515
IN NAME OF

ROBERT J. KILKENNY

Surveyed 22 Oct. 1958, by M. Bieh