


**T. 37 S., R. 11 1/2 E., W.M.**

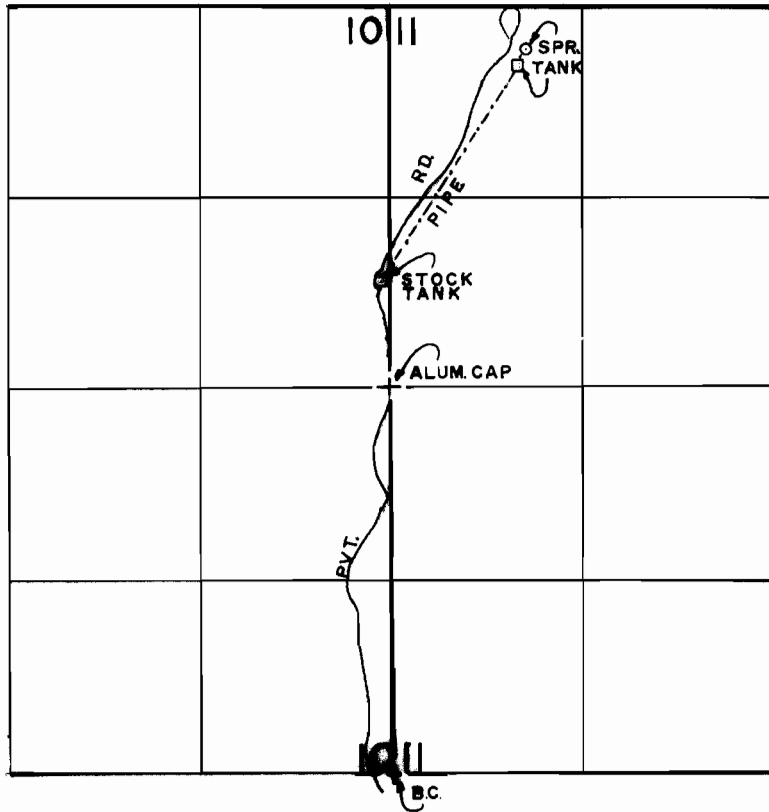

SPRING LOC: 300'S & 940' E FROM NW COR. OF SEC II.

SCALE: 1" = 1320'

**FINAL PROOF SURVEY**

UNDER

Application No. 56094 Permit No. 42352  
IN NAME OF

**PERRY A. LANGER**

Surveyed AUG 4, 1994, by R.M.SUTTERFIELD