


T.33S.,R.17E.W.M.

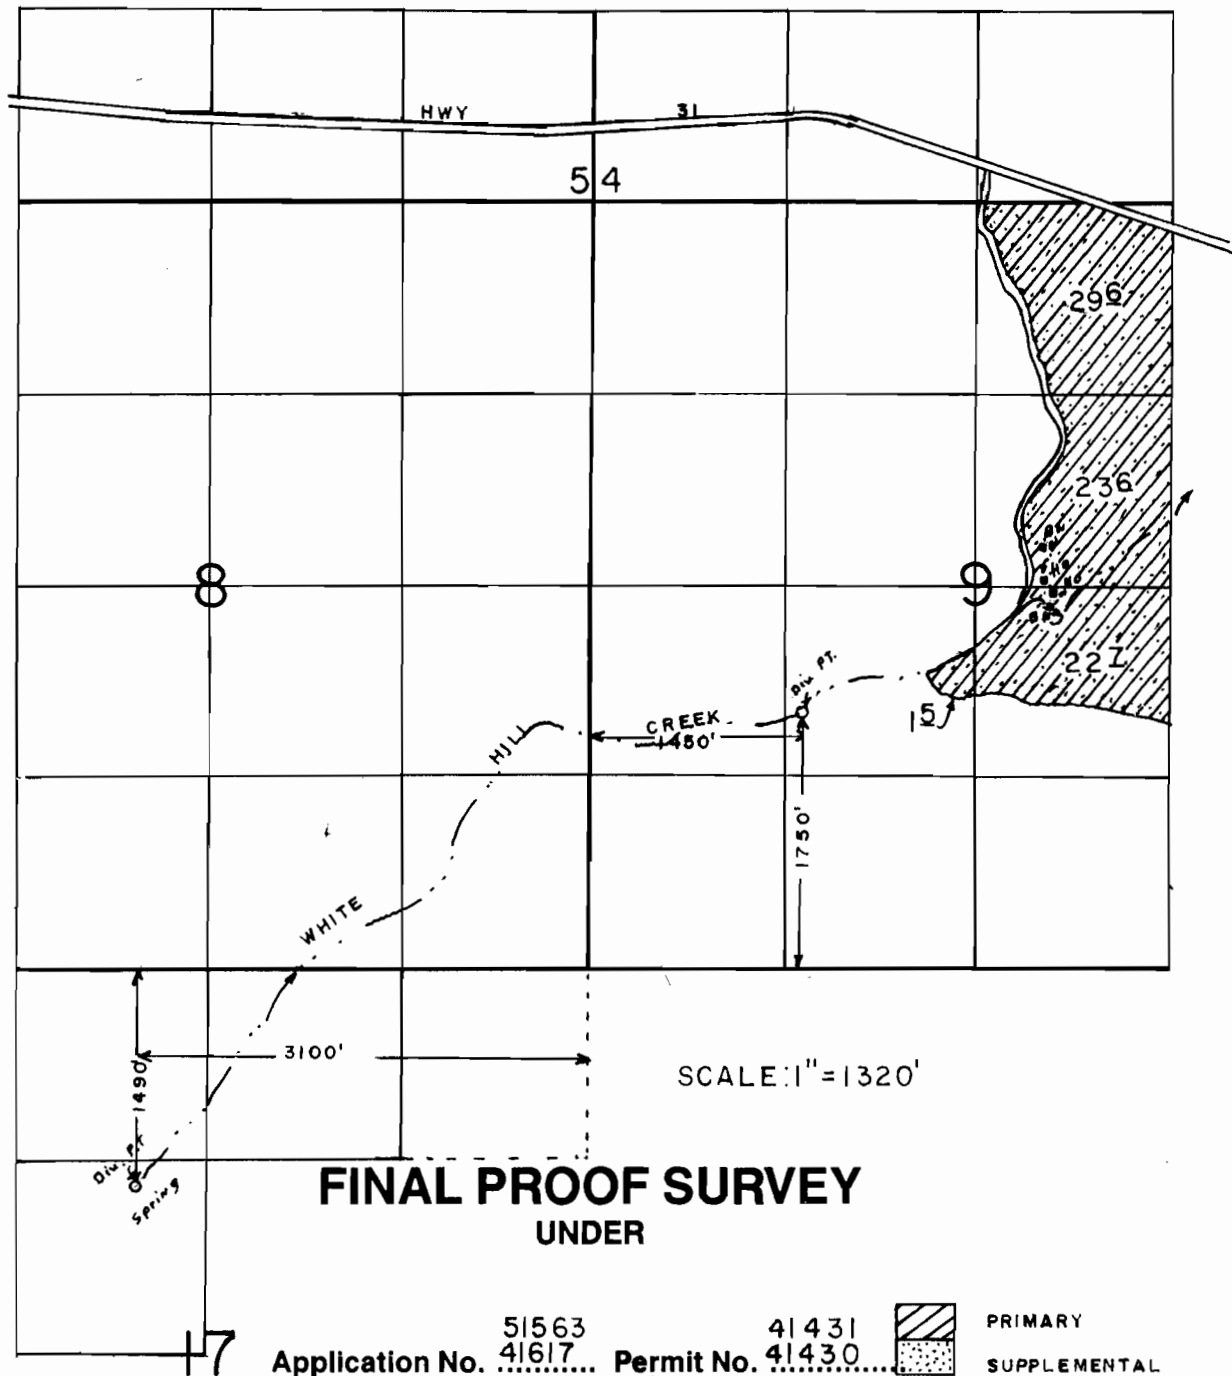

**FINAL PROOF SURVEY
UNDER**

Application No. 51563 41431
41617 Permit No. 41430
IN NAME OF



PRIMARY
SUPPLEMENTAL

JAMES R. & MARY DIANE ELDER.

Surveyed OCT. 12.. 1994., by R.M. SUTTERFIELD