


T. 33S., R. 17E. W.M.

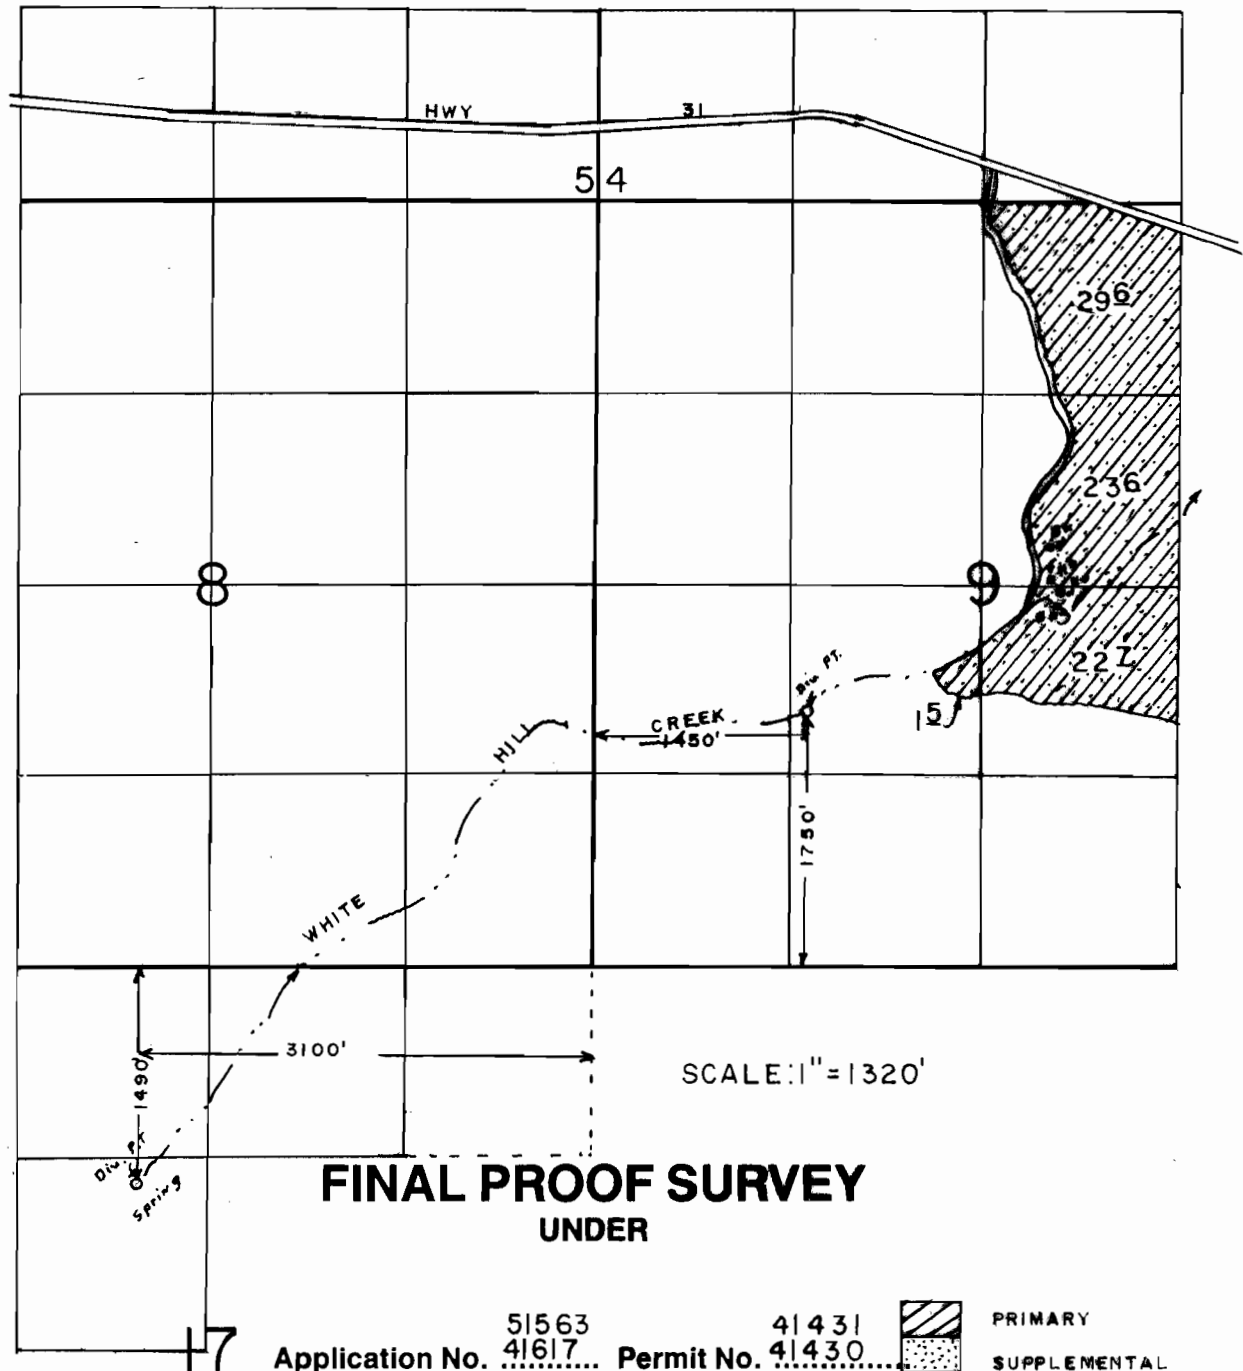

**FINAL PROOF SURVEY  
UNDER**

Application No. 51563 41431 Permit No. 41430  
IN NAME OF

JAMES R. & MARY DIANE ELDER

Surveyed OCT. 12, 1994, by R.M. SUTTERFIELD