


Cert# 8268

9090

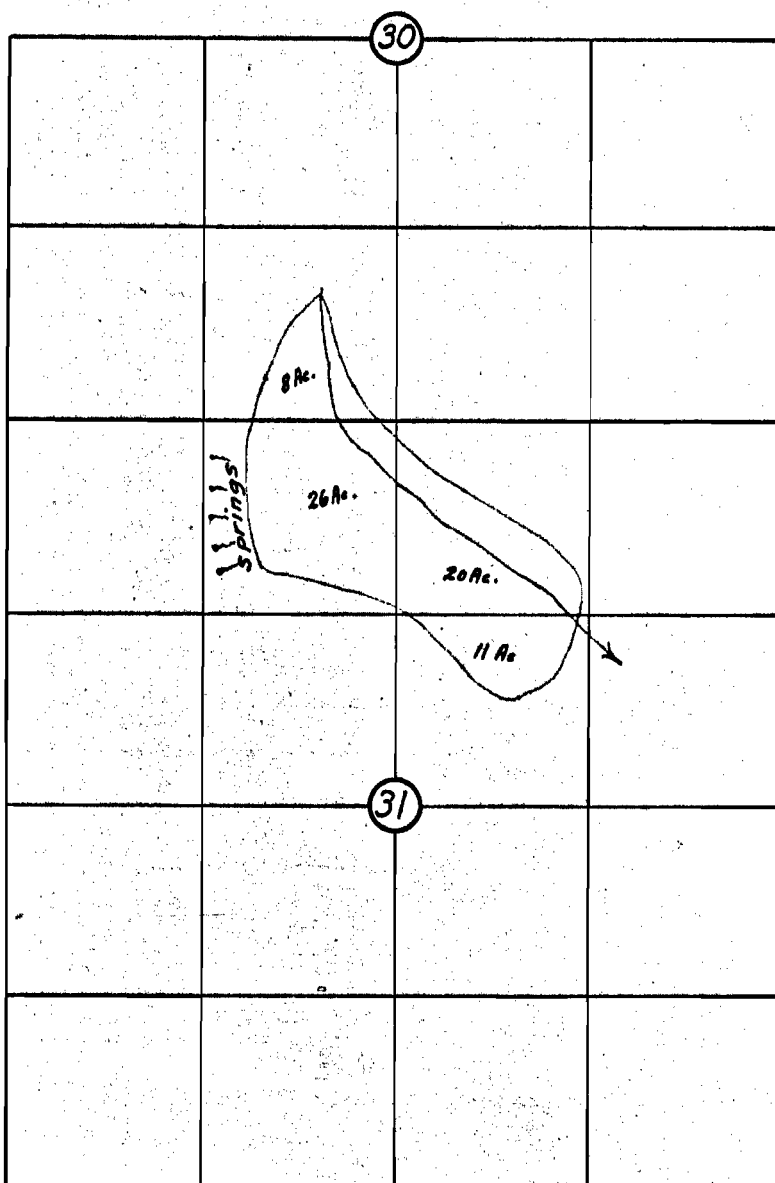

Scale 4" = 1 Mile.

Application No. 12782
Permit No. 9090