


T. 7 S., R. 46 E., W.M.

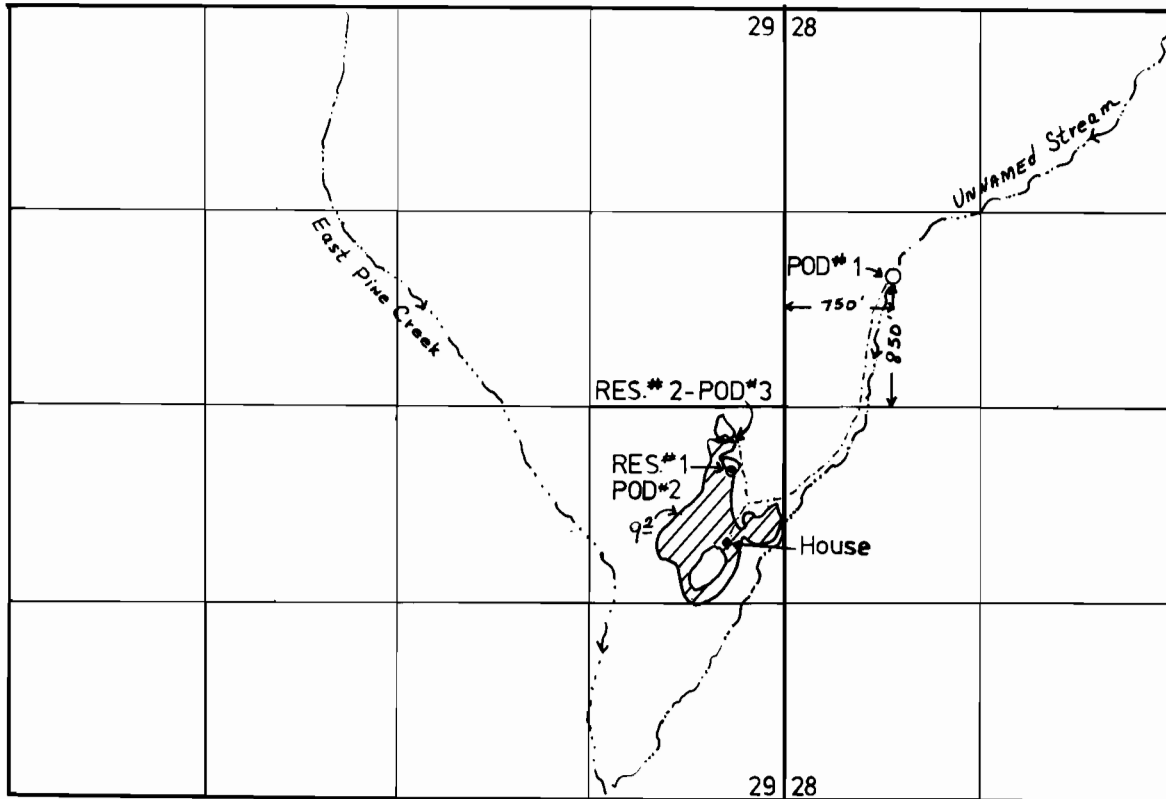

POD RES.-1 - 430'S. & 350'W., POD RES.-2 - 220'S. & 380'W., BOTH BEING FROM THE W 1/4 QUARTER CORNER SECTION 28.

N
1" = 1320'

FINAL PROOF SURVEY

UNDER

Application No. <u>61946</u>	Permit No. <u>46479</u>
<u>64564</u>	<u>47267</u>
<u>R-64174</u>	<u>R-8550</u>
<u>R-63112</u>	<u>R-8368</u>

IN NAME OF

ANTHONY E. AND PATRICIA J. SOWERS

Surveyed 8-13, 1990, by K. KEMP