


T. 7 S., R. 46 E., W.M.

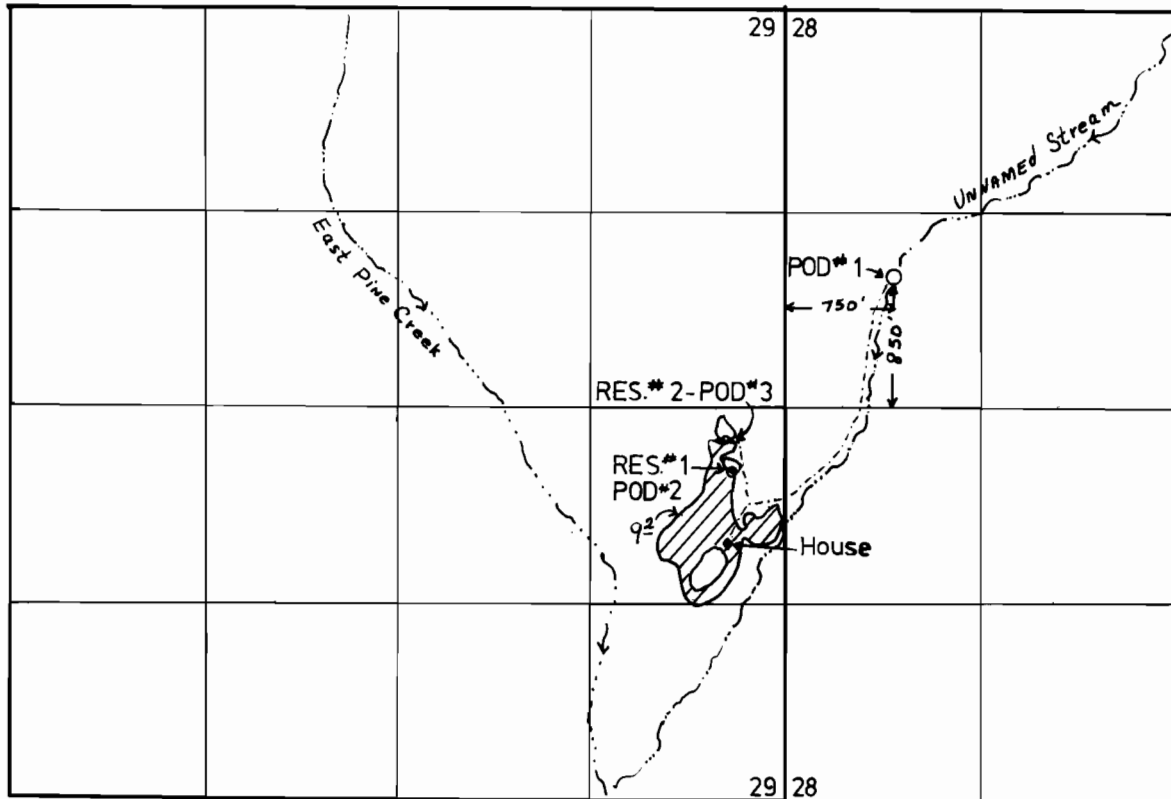

POD RES.-1-430'S. & 350'W., POD RES.-2-220'S. & 380'W., BOTH BEING FROM THE W 1/4 QUARTER CORNER SECTION 28.

N
1" = 1320'

FINAL PROOF SURVEY

UNDER

Application No. 61946	Permit No. 46479
64564	47267
R-64174	R-8550
R-63112	R-8368

IN NAME OF

ANTHONY E. AND PATRICIA J. SOWERS

Surveyed 8-13, 1990, by K. KEMP