


T. 27 S., R. 23 E., W.M.

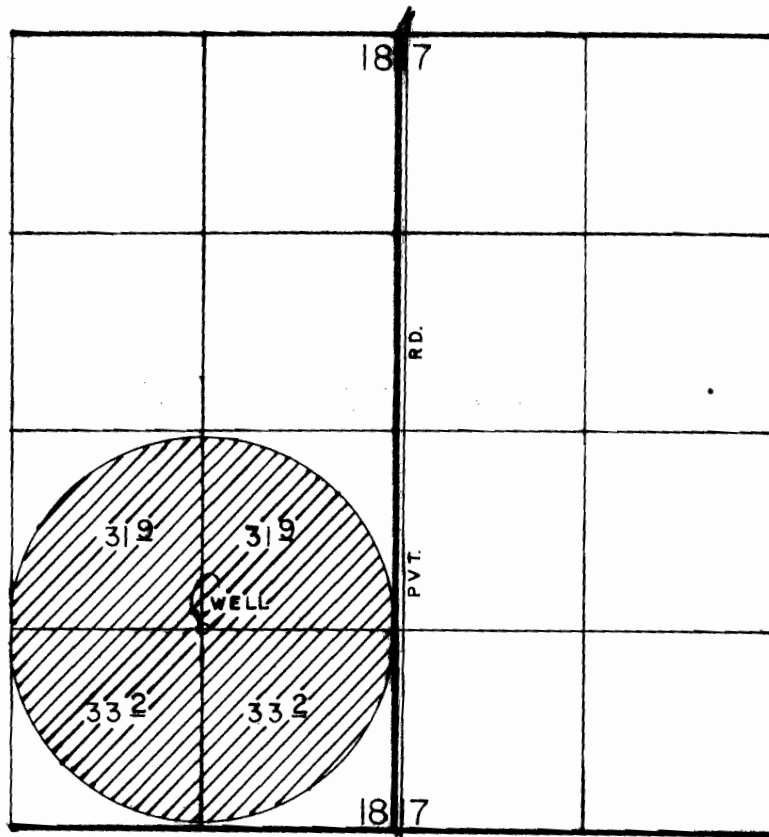

WELL LOC: 1350' N & 1350' W FROM SE COR. OF SEC 18.

SCALE: 1" = 1320'

FINAL PROOF SURVEY
UNDER

Application No. G-11486 Permit No. G-10592
IN NAME OF

JOHN M. PEILA JR.

Surveyed MARCH 7, 1995, by R.M. SUTTERFIELD

130' ±