


T. 27 S., R. 14 E., W.M.

11/23/93

FEB - 8 1994

WATER RESOURCES DEPT
SALEM, OREGON

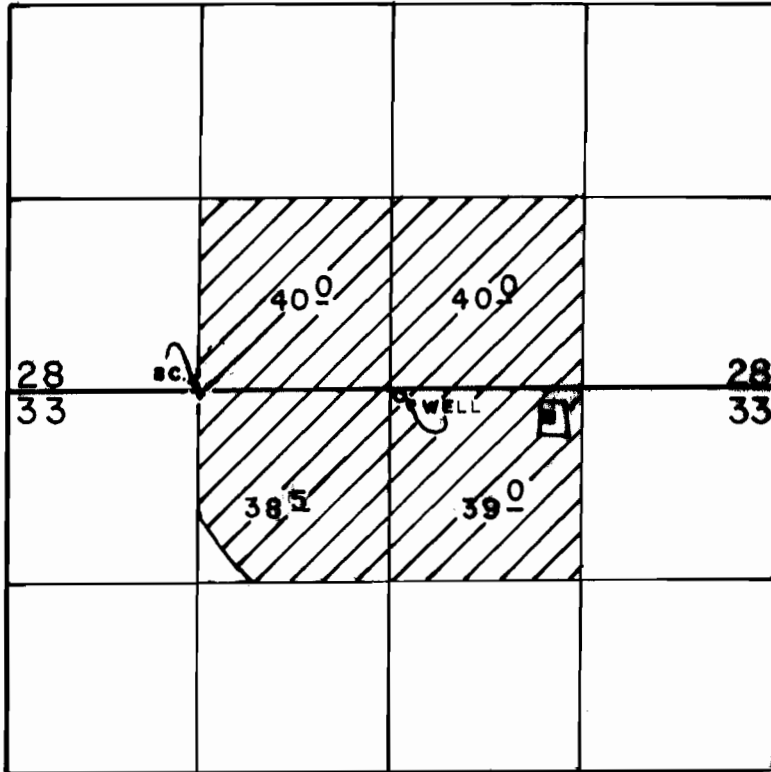

WELL LOG: 30' S & 1370' E FROM NW COR. OF NE 1/4 NW 1/4 OF SEC 33.

SCALE: 1" = 1320'

FINAL PROOF SURVEY

UNDER

Application No. G-11281 Permit No. G-10706
IN NAME OF

HIDE-OUT RANCH

Surveyed APRIL 16, 1993, by R.M.SUTTERFIELD