


TOWNSHIP 6 SOUTH, RANGE 43 EAST, W.M.

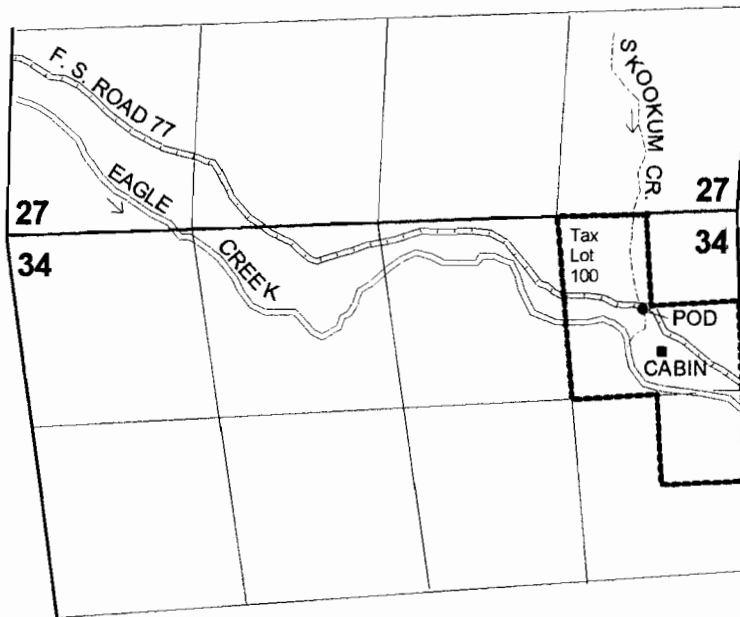

POD - 650 FEET SOUTH AND 670 FEET WEST OF THE NORTHEAST CORNER OF SECTION 34.

FINAL PROOF SURVEY

UNDER

Application No. 48917 Permit No. 35968

IN THE NAME OF

JANE F. KUSAKA AND TERRY SHUMWAY

Surveyed: July 10, 2002 by: J. Miller

RECEIVED

MAR 03 2003

WATER RESOURCES DEPT.
SALEM, OREGON