


T. 14 S., R. 30 E., W. M.

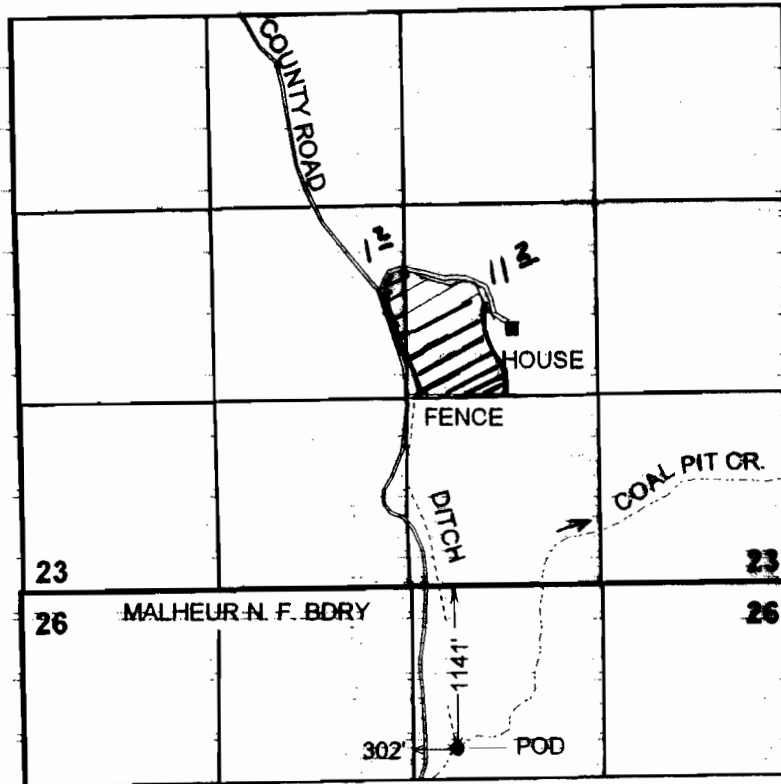

1" = 1320'

FINAL PROOF SURVEY
UNDER

Application No. 61926 Permit No. 45645
IN NAME OF

ROBERT CHRISTOPHER NOLAN

Surveyed 8/07 2000 by L. Miller

REDRAFTED 6/21/06 JWG