


T. 17 S., R. 5 W., W.M.

FERN RIDGE
RESERVOIR

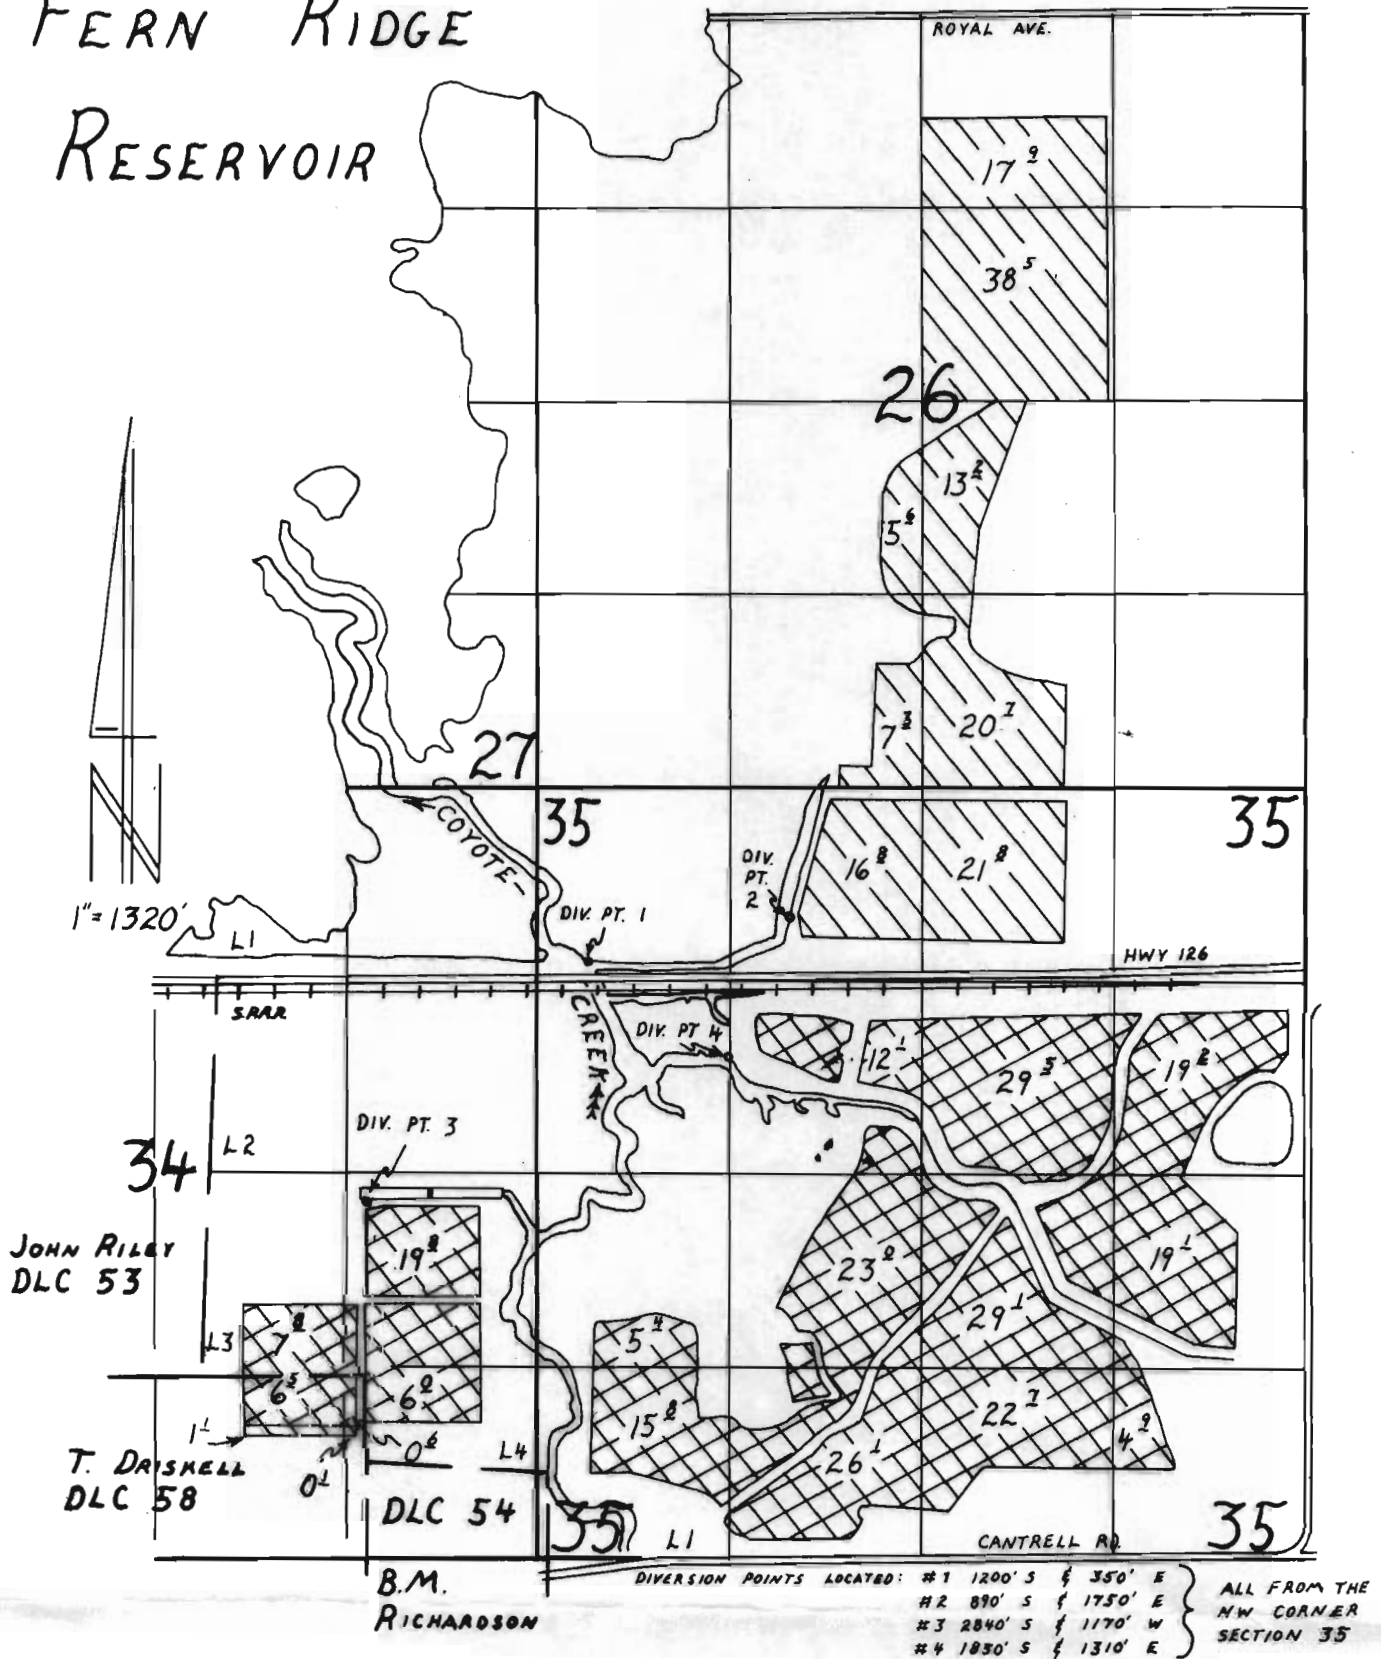

FINAL PROOF SURVEY

UNDER

Application No. 18043 Permit No. 49870
IN NAME OF

Oregon Department of Fish & Wildlife

Surveyed June 9, 1994, by R.W. Klassen