


T. 30 S., R. 16 E., W.M.

RECEIVED

FEB - 8 1994

WATER RESOURCES DEPT.
SALEM, OREGON

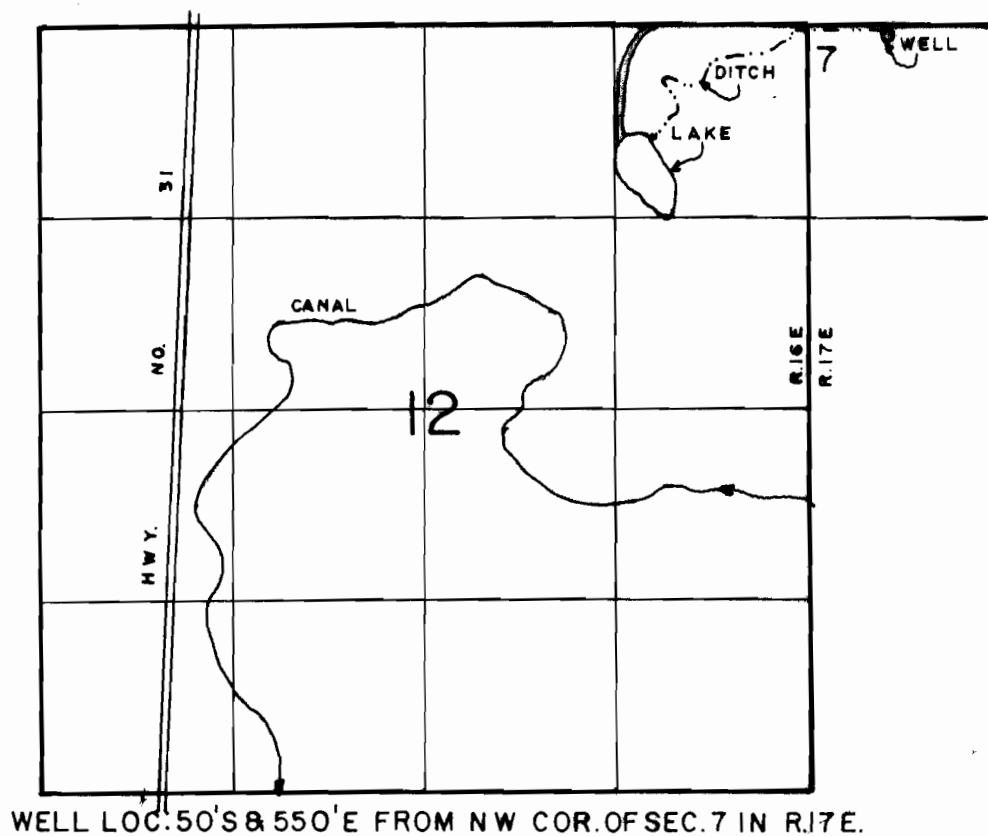

SCALE: 1" = 1320'

FINAL PROOF SURVEY

UNDER

Application No. ~~G-10831~~ Permit No. ~~G-10092~~
IN NAME OF

OREGON DEPARTMENT OF FISH AND WILDLIFE

Surveyed OCT 19, 1993, by R.M. SUTTERFIELD