T2N., R13E., W.M.

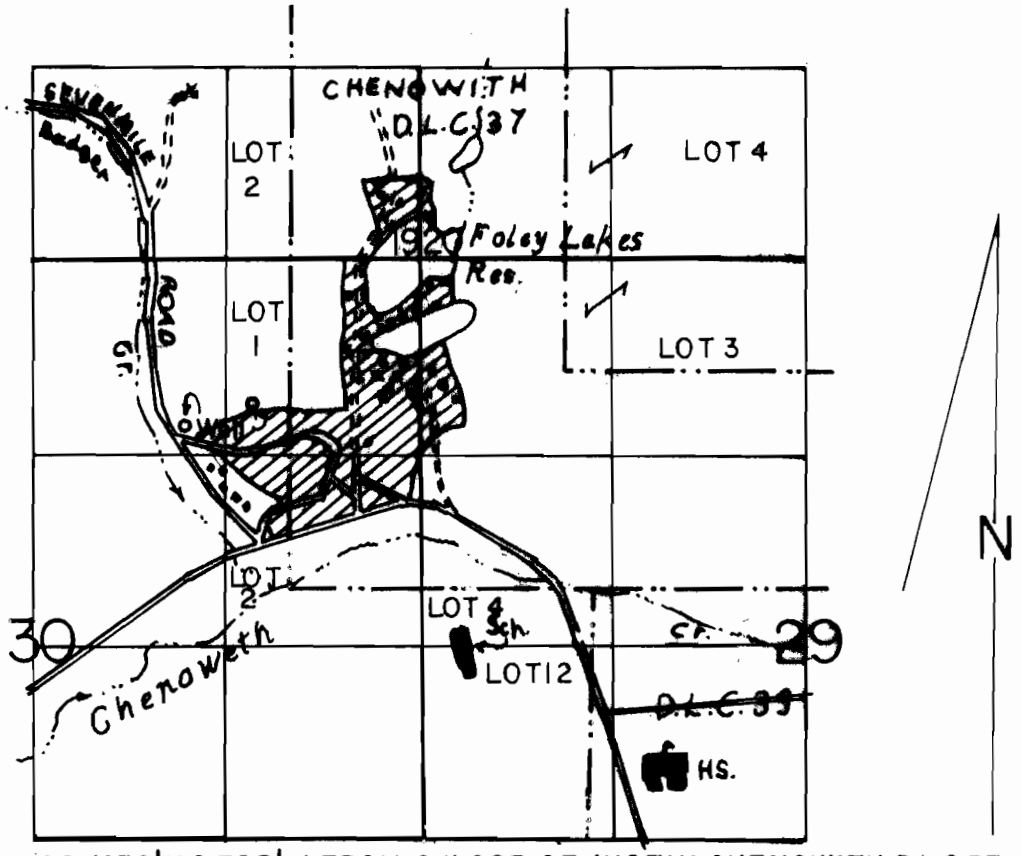

WELL LOC: 1150' N & 720' W FROM SW COR. OF JUSTIN CHENOWITH D.L.C. 37

SCALE: 1" = 1320'

FINAL PROOF SURVEY
UNDER

Application No. G-9705 **Permit No.** G-9968
IN NAME OF

ARTHUR W. PULLEN

Surveyed MAY 16, 1995, **by** R.M. SUTTERFIELD

PHOTO SURVEY 41065-179-234-R 1/2/96 R.M.S.