


**T. 23 S., R. 46 E., W.M.**

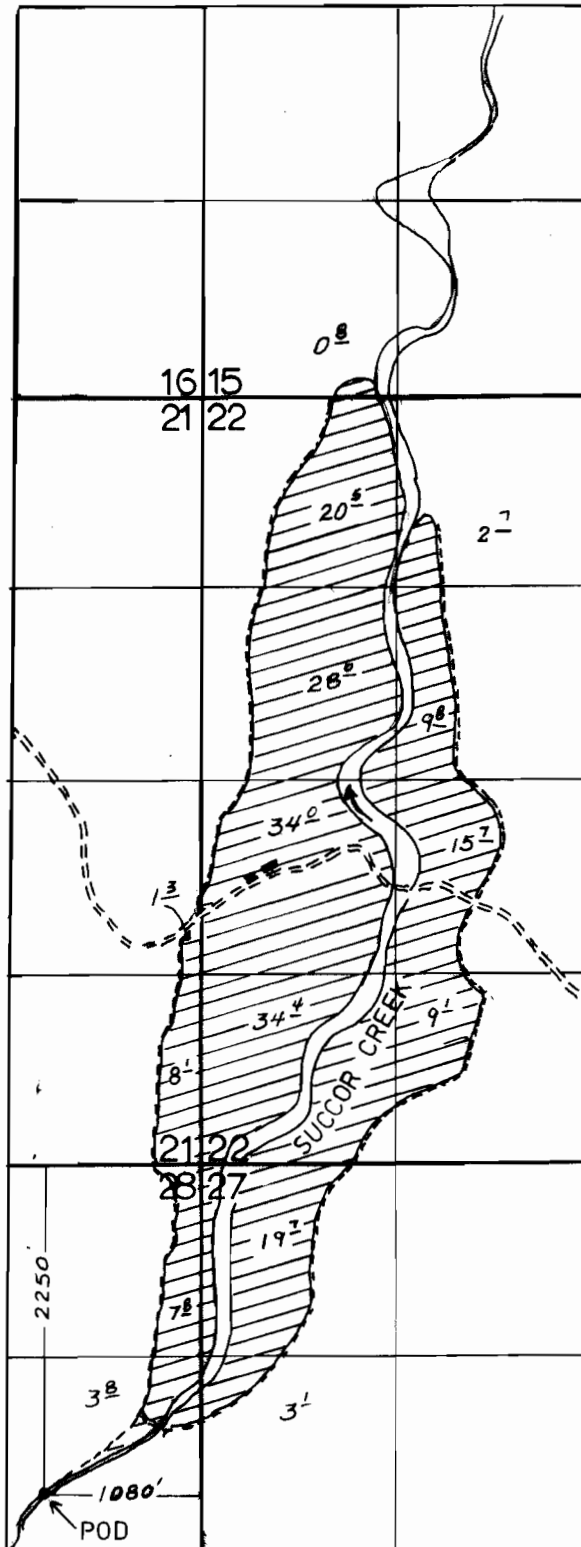

**FINAL PROOF SURVEY**  
UNDER

Application No. 68810 Permit No. 49924  
IN NAME OF

RICHARD A. SPRINGS, III AND DEBORAH B. SPRINGS

Surveyed OCTOBER 13, 1994, by J. MILLER