


T5S, R11E, WM.

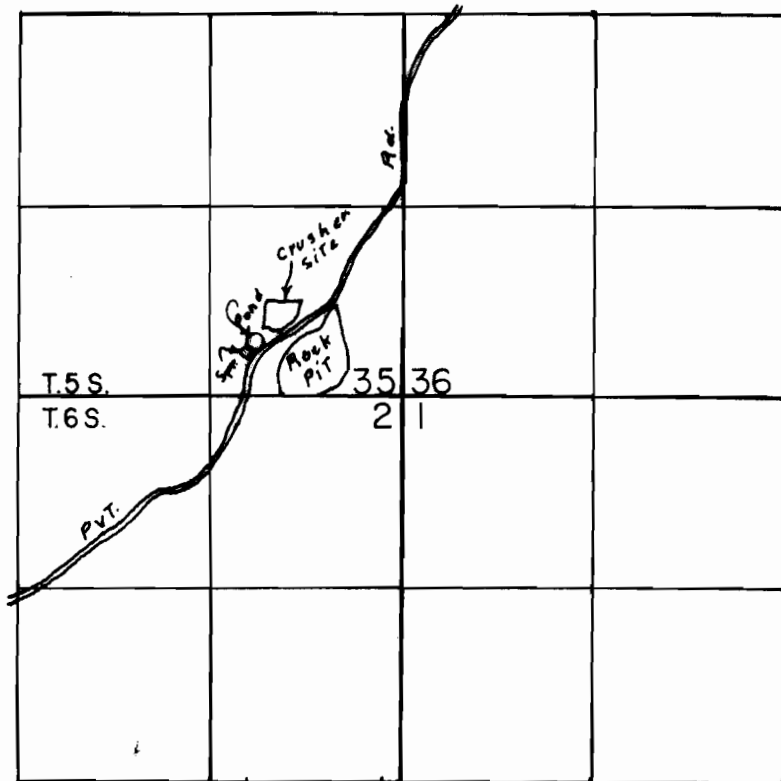

SPRG LOC. 290' N & 1075' W FROM SE COR. OF SEC 35.

SCALE: 1" = 1320'

## FINAL PROOF SURVEY UNDER

Application No. 58344 Permit No. 44210.....

IN NAME OF

WASCO COUNTY, A MUNICIPAL CORP.  
AND POLITICAL SUBDIVISION OF THE  
STATE OF OREGON

Surveyed AUG 14, 1995, by R.M. SUTTERFIELD