


TOWNSHIP 11 S. RANGE 40 E.W.M.

5 1/2 NW 1/4 SE 1/4 Sec, 15

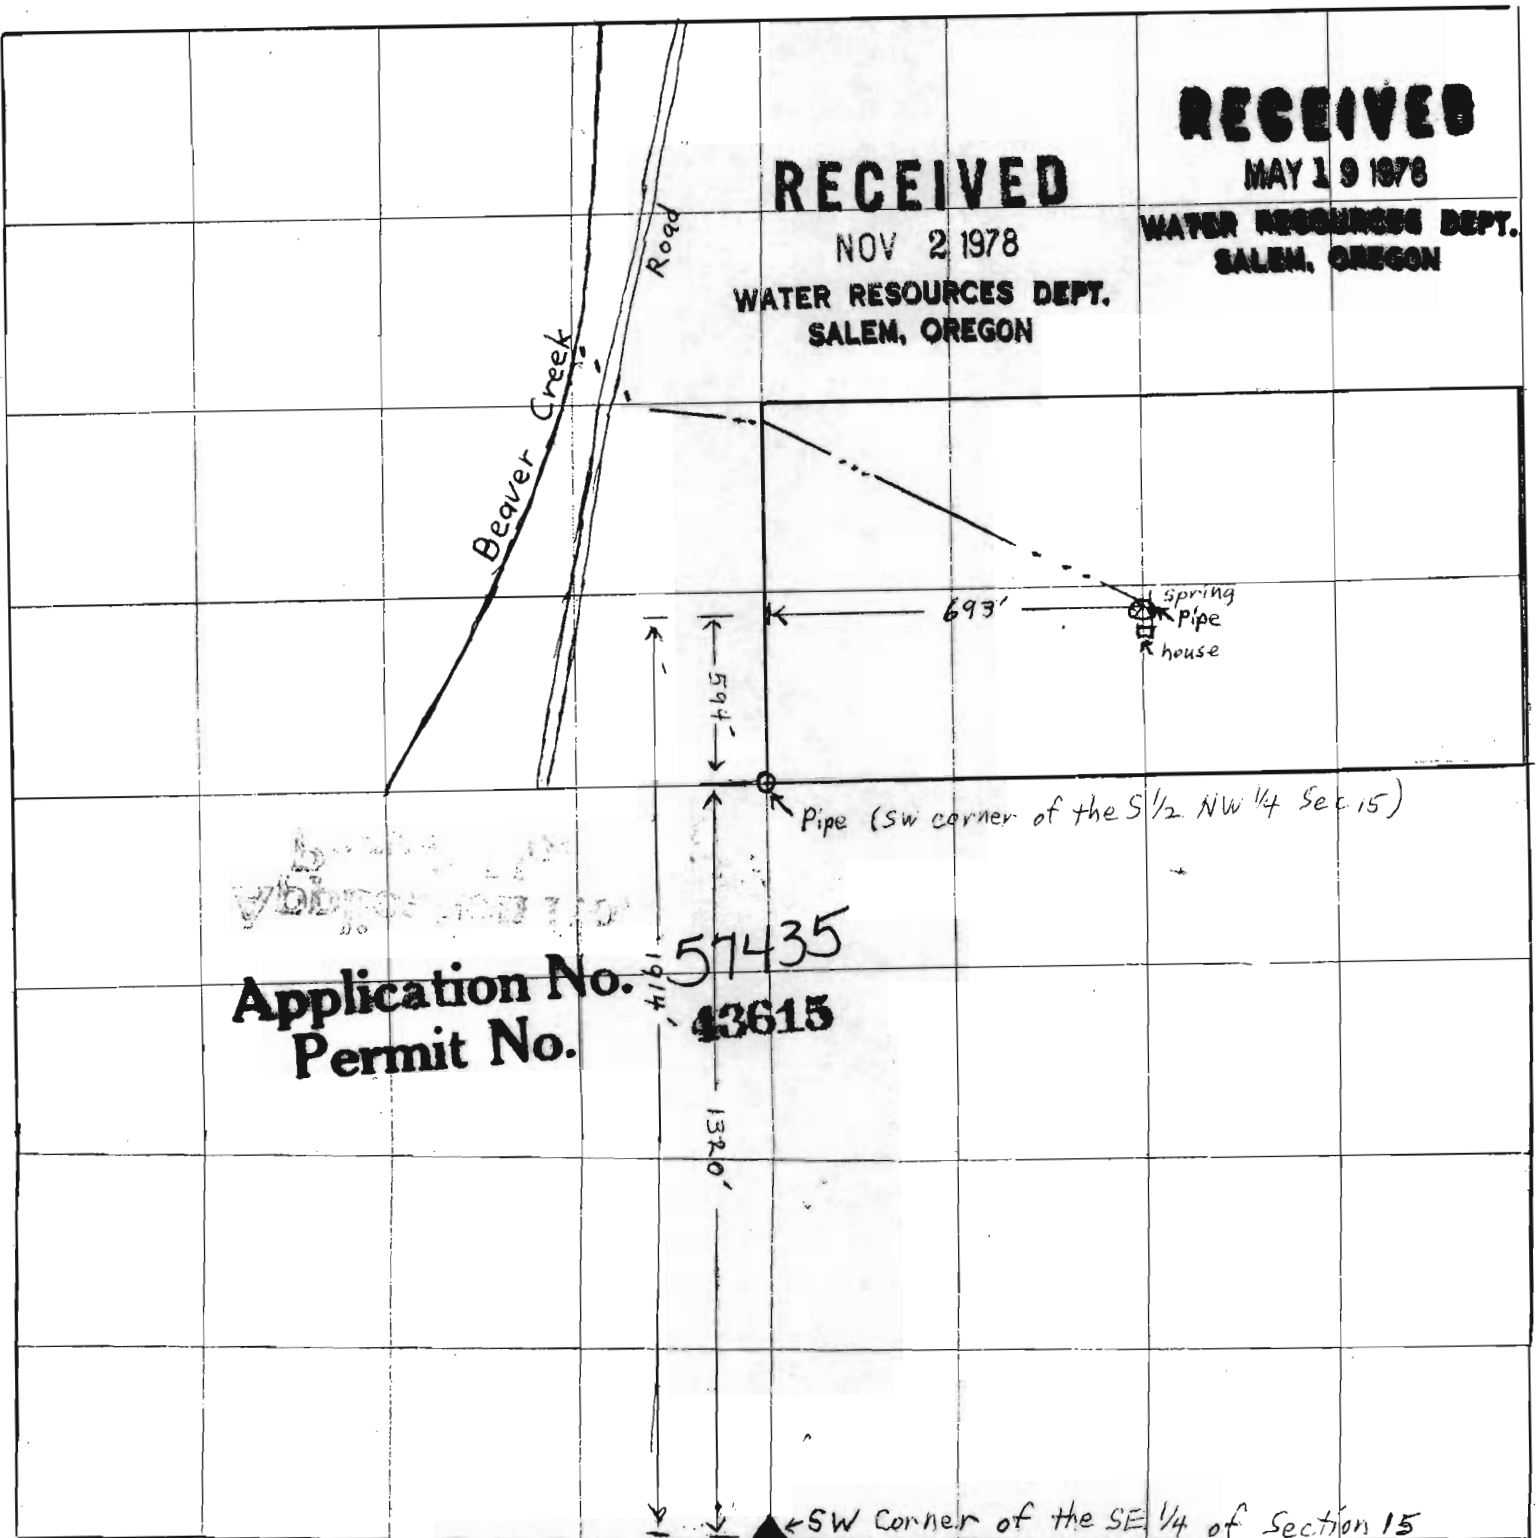

MAP TO ACCOMPANY APPLICATION OF:

Name Timothy John Jones

County Baker

Date 5/16/78

Scale 16 inches to 1 Mile

Note:

MAP PREPARED FROM: Measurements, compass bearing:

MAP DRAWN BY: Timothy John Jones

SIGNED BY APPLICANT: Timothy John Jones