


T. 33 S., R. 17 E., W.M.

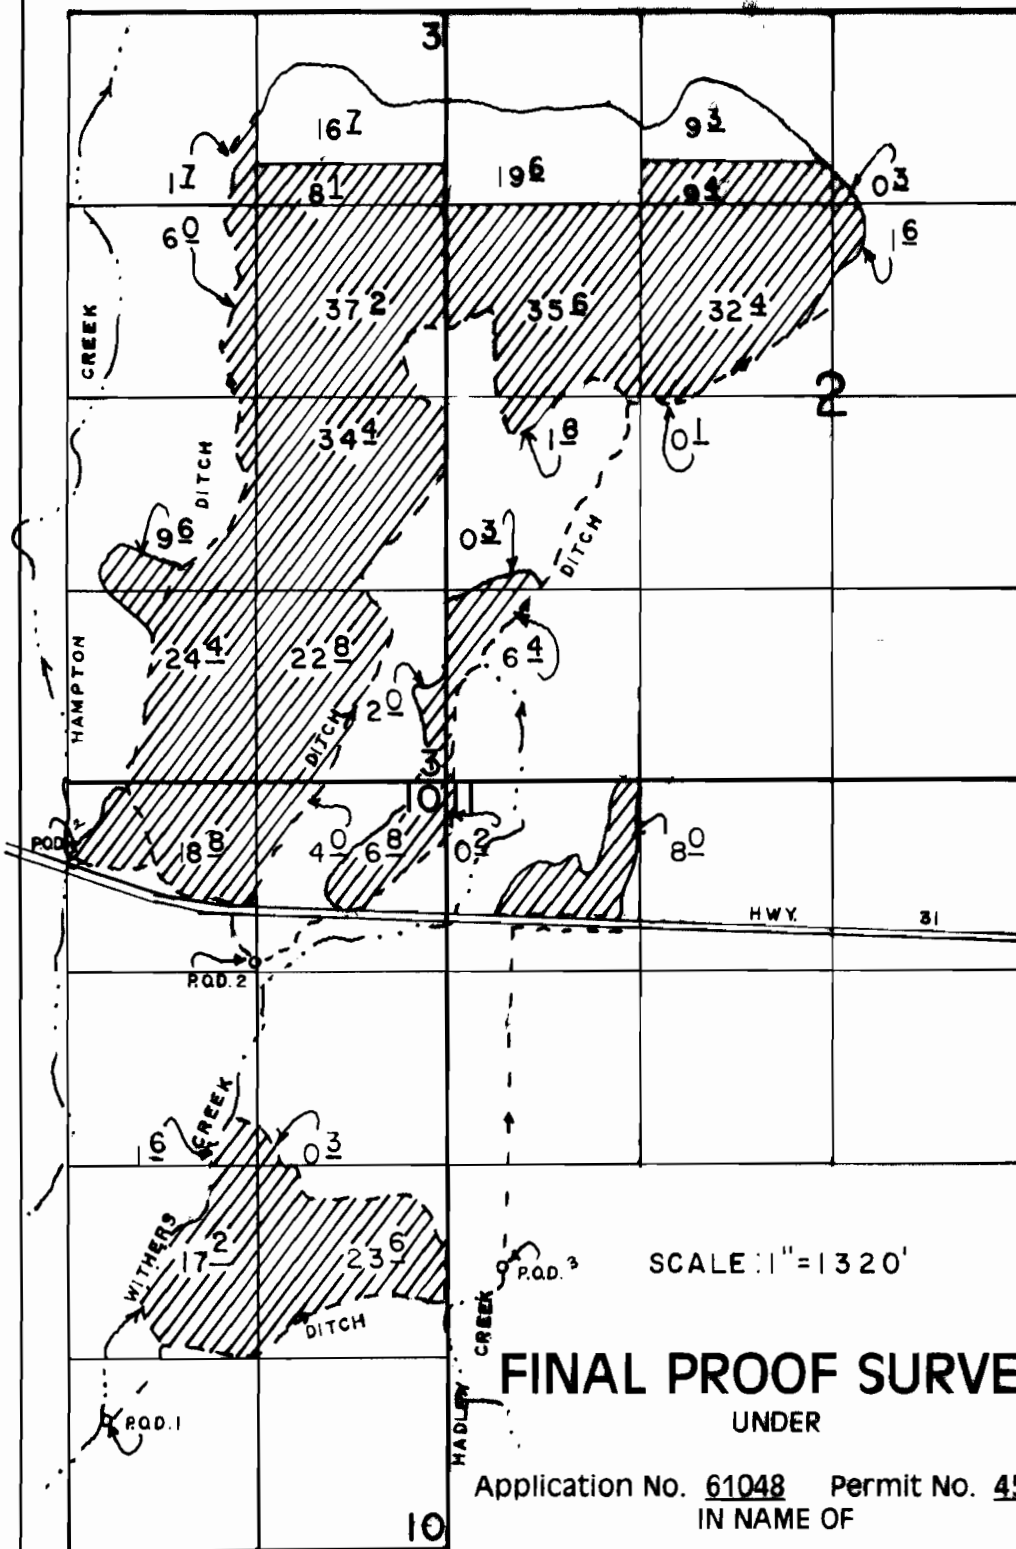

P.O.D. 1. 890' N & 2360' W FROM SE COR. OF SEC 10.
P.O.D. 2. 1250' S & 1330' W FROM NE COR. OF SEC 10.
P.O.D. 3. 1930' N & 380' E FROM SW COR. OF SEC 11.
P.O.D. 4. 550' S & 2600' W FROM NE COR. OF SEC 10.

SCALE: 1" = 1320'

FINAL PROOF SURVEY

UNDER

Application No. 61048 Permit No. 45595
IN NAME OF

WITHERS RANCH, INC

Surveyed APRIL 13, 1994, by R.M. SUTTERFIELD