


**T. 22 S., R. 32 E., W.M.**

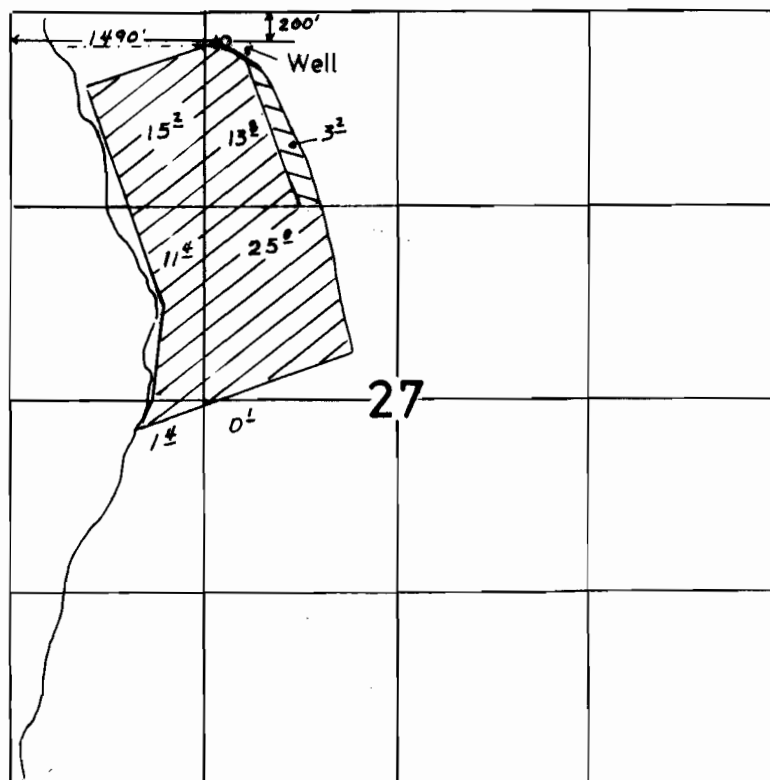

 PRIMARY

 SUPPLEMENTAL

**FINAL PROOF SURVEY**

UNDER

Application No. G-8892 Permit No. G-8309  
IN NAME OF

ROGER TILLER

Surveyed JULY 18, 1996, by J. MILLER