
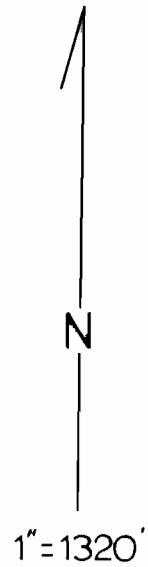


T. 26 S., R. 33 E., W.M.

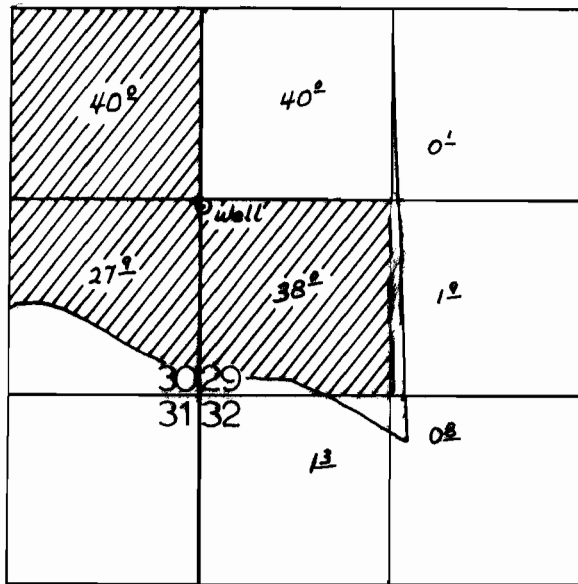

FINAL PROOF SURVEY

UNDER

Application No. G-11328 Permit No. G-10466
IN NAME OF

JOHN WOOSTER

Surveyed 10-31, 1990, by K. KEMP

6/19/06
AMENDED 6/15/06 LHN
Drafted 3-31-93 J.M. 41025-179-2898