


**T. 26 S., R. 33 E., W.M.**

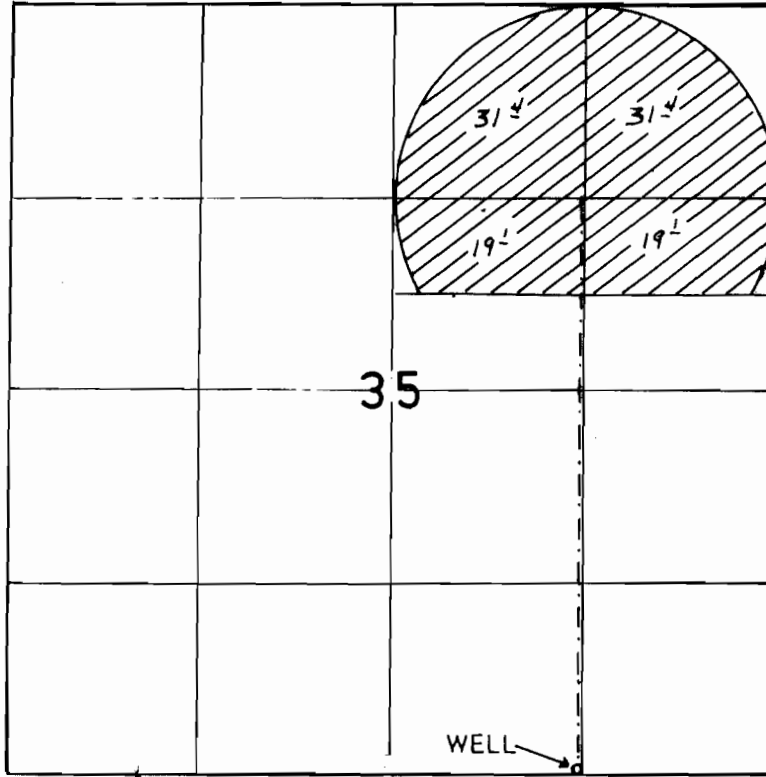

WELL - 45' N. & 1300' E. FROM THE S 1/4 COR. SECTION 35.

**FINAL PROOF SURVEY**

UNDER

Application No. G-10013 Permit No. G-9160  
IN NAME OF

FRED KREGER

Surveyed AUGUST 6, 1993, by J. MILLER