


T. 23 S., R. 34 E., W.M.

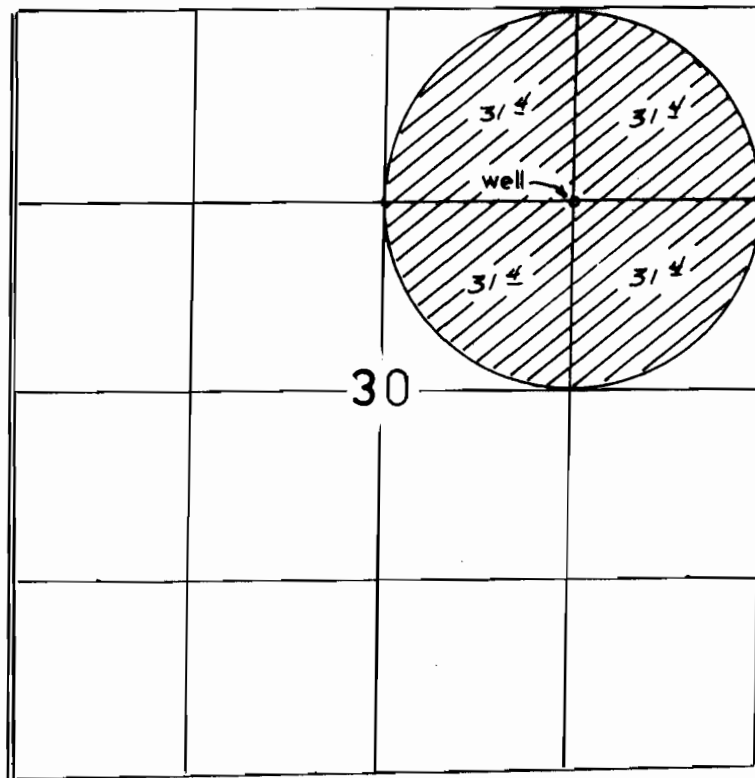

1" = 1320'

Well - 1320' S. & 1320' W. from NE Cor.
Section 30.

FINAL PROOF SURVEY

UNDER

Application No. G-10213 Permit No. G-9346
IN NAME OF

OREGON DEPARTMENT OF VETERANS AFF.

Surveyed NOVEMBER 10, 1992 by J. MILLER