


T. 41 S., R. 33 E., W.M.

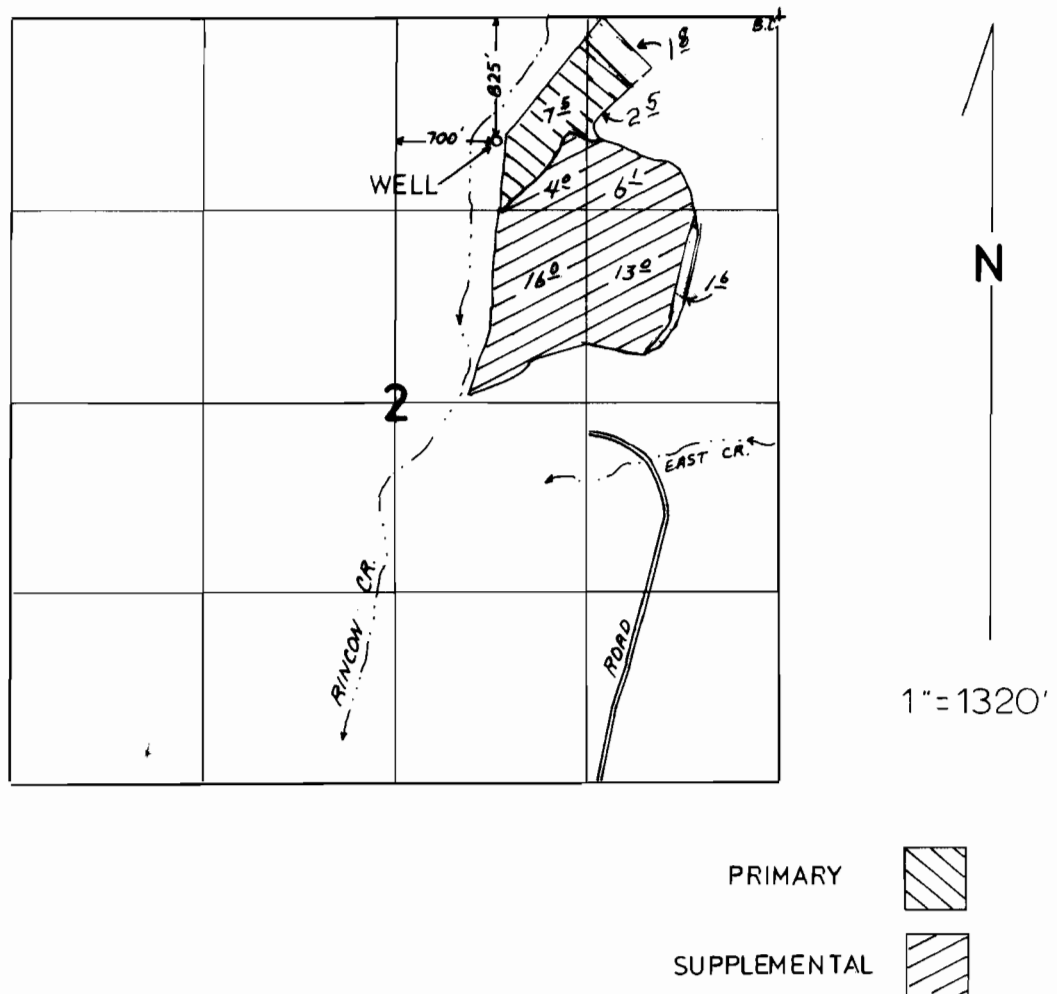

FINAL PROOF SURVEY UNDER

Application No. G-10222 Permit No. G-9804

IN NAME OF

RONALD MC LEAN

Surveyed SEPTEMBER 15, 1994, by J. MILLER

RECEIVED

MAY - 2 1996

WATER RESOURCES DEPT
SALEM, OREGON