
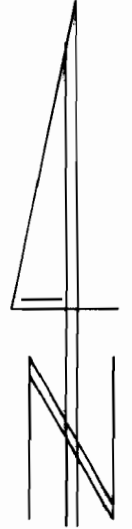


T. 16 S., R. 3 W., W.M.

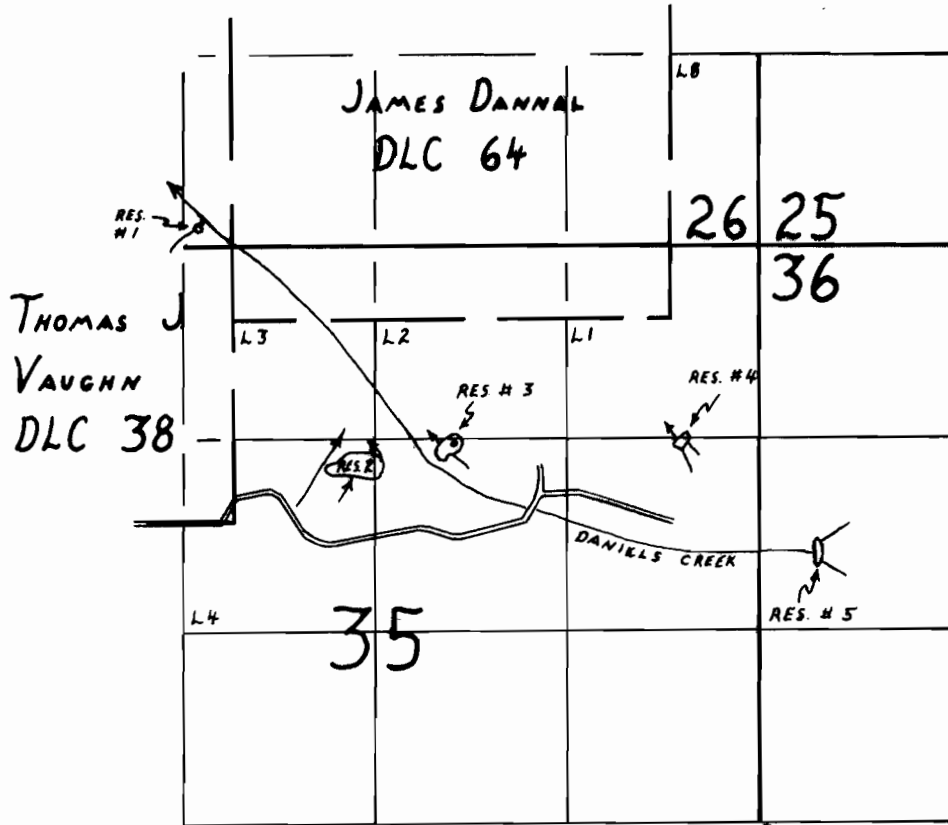

1" = 1320'

RESERVOIR LOCATIONS:	# 1	2040' N	230' W	} ALL FROM THE SE CORNER DLC 38
	# 2	440' N	1010' E	
	# 3	540' N	1420' E	
	# 4	560' N	3040' E	
	# 5	220' S	3970' E	

FINAL PROOF SURVEY

UNDER

Application No. R-68084 & 68085 Permit No. R-9966 & 48680
IN NAME OF

Bob Meltebeke, Bertrand & Loimae Dotson,
Vico & Beverly Bondietti, and Valorie R & Dennis M Schuelke

Surveyed June 9, 1994, by R.W. Klassen