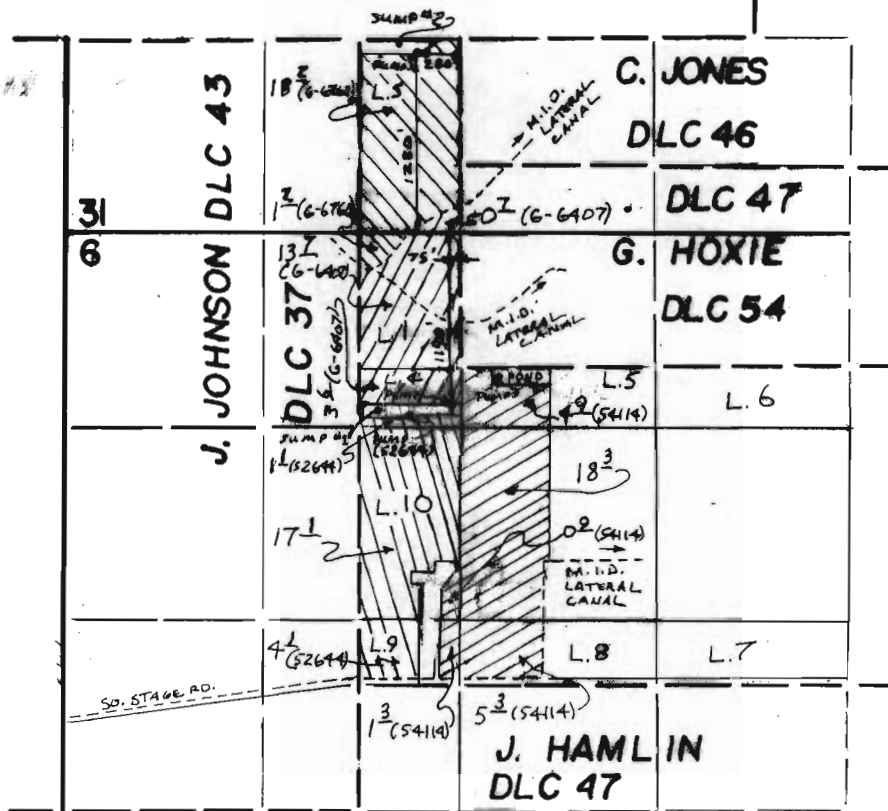

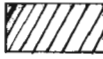


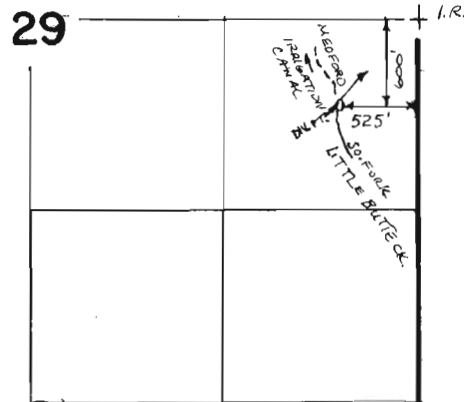
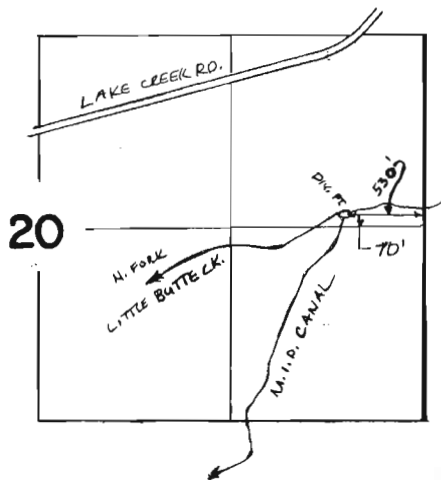


T. 37S. & 38S., R. 1W., W.M.



-  TEMP. CONTROL UNDER G-6760
-  TEMP. CONTROL UNDER G-6407
-  TEMP. CONTROL UNDER 52644
-  TEMP. CONTROL UNDER 54114

T. 36 S., R. 2E., W.M.



SCALE: 1" = 1320'

**FINAL PROOF SURVEY**

UNDER 52644

39180

G-6760

G-6280

G-6407

G-5805

Application No. 54114 Permit No. 40510

IN NAME OF

MODOC ORCHARD COMPANY C/O BEN DARRAS

Surveyed MARCH 21 1984 by B. S. JAMES

6/29/06 JWG  
41029-279-24R JRW