


TOWNSHIP 3 NORTH, RANGE 46 EAST, W.M.

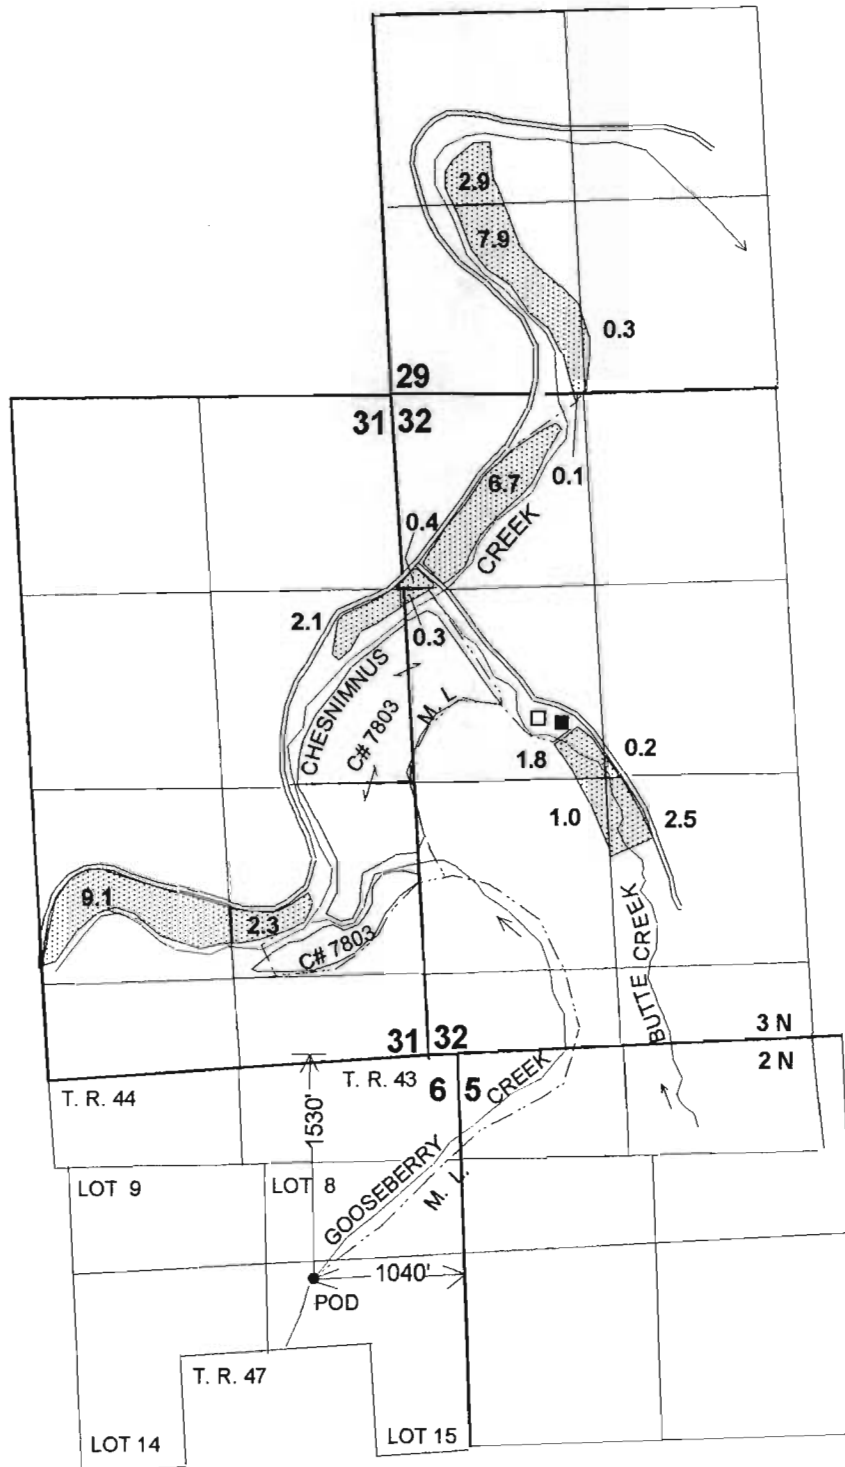

FINAL PROOF SURVEY
 UNDER
Application 68049 Permit 48752
 IN THE NAME OF
PAUL YOST

Surveyed: June 20, 2002 by: J. Miller

RECEIVED

FEB 03 2003

WATER RESOURCES DEPT.
 SALEM, OREGON