


T. 30S., R. 9E., W.M.

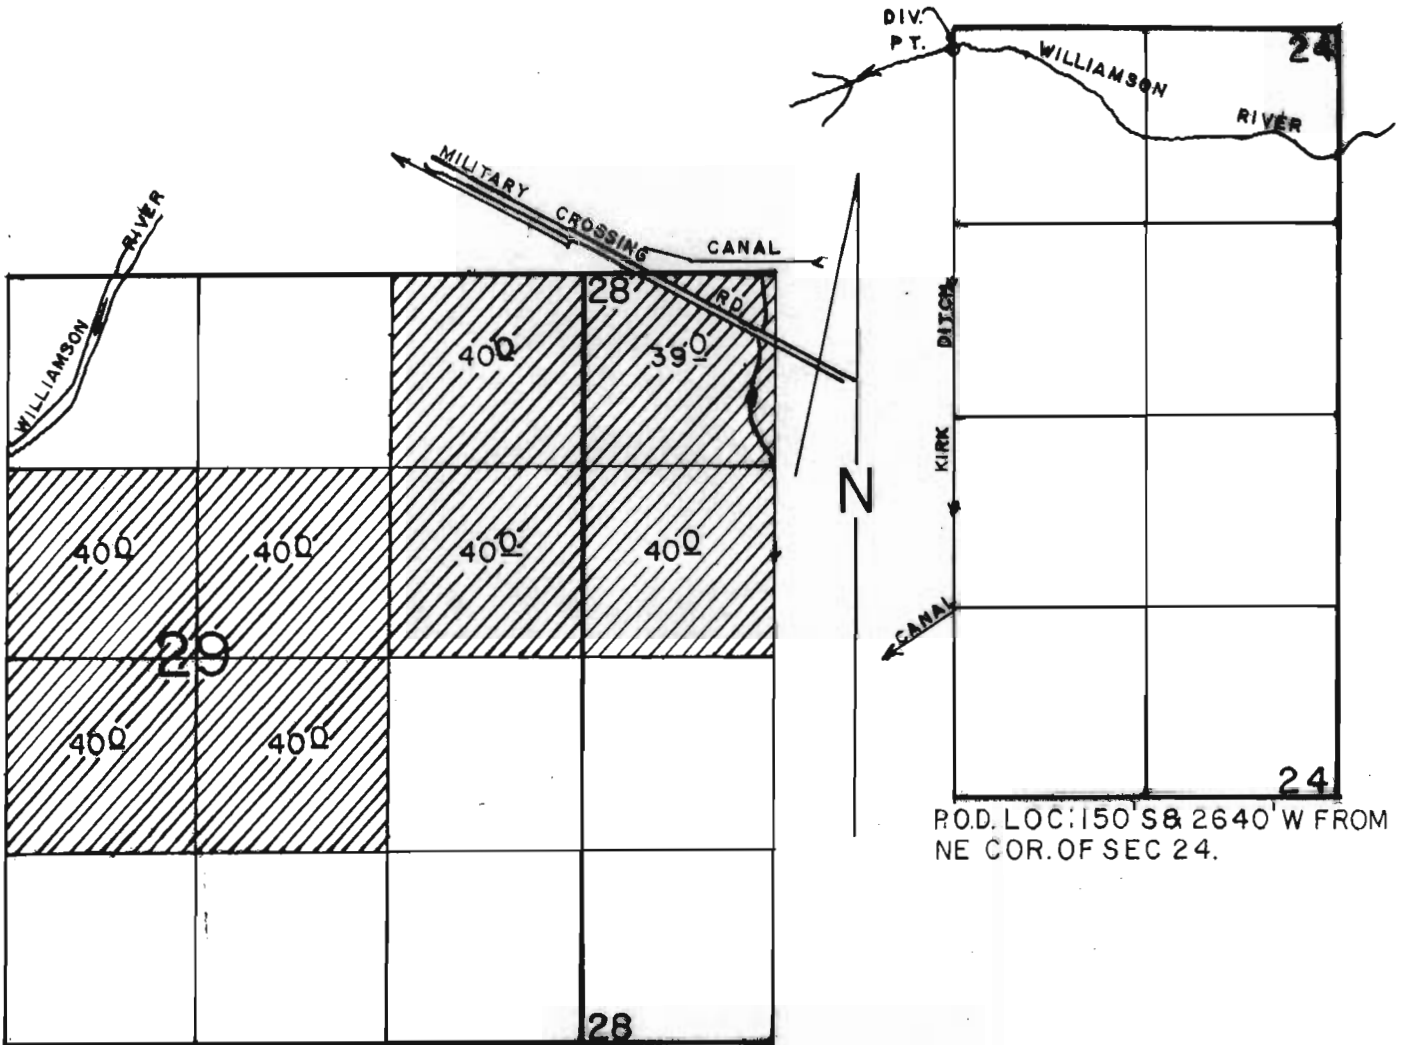

SCALE: 1" = 1320'

FINAL PROOF SURVEY
UNDER

Application No. 58917 Permit No. 44534
IN NAME OF

JOHN C. HORTON

Surveyed JUNE 29, 1994, by R.M. SUTTERFIELD