


T. 25S., R. 33E., W. M.

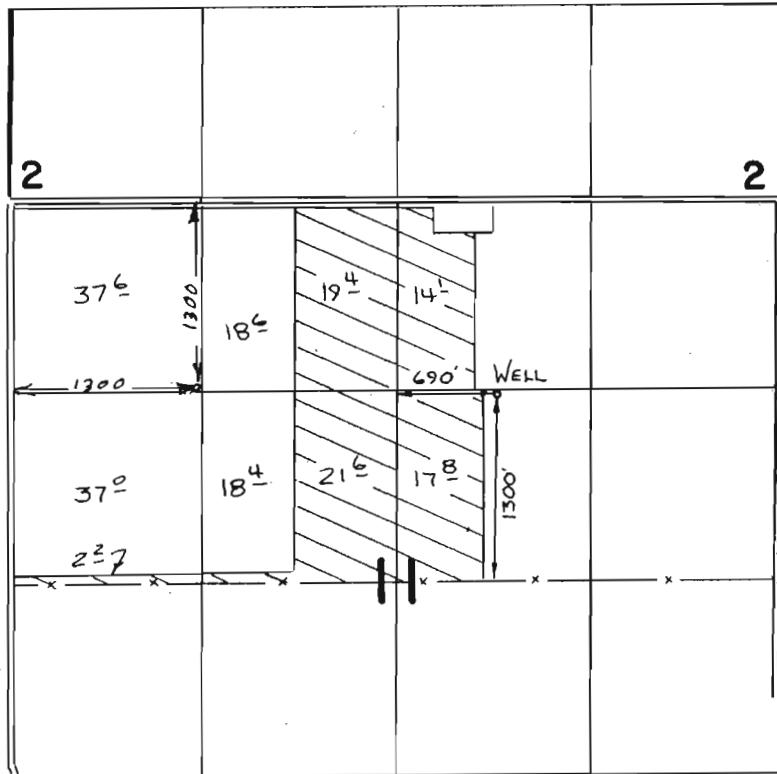

SCALE 1" = 1320'

FINAL PROOF SURVEY
UNDER

Application No. **G:7649** Permit No. **G:7076**
IN NAME OF

DVA

Surveyed ...5-7... 1988, by *V.L. Church*