


T. 25S., R. 33E., W.M.

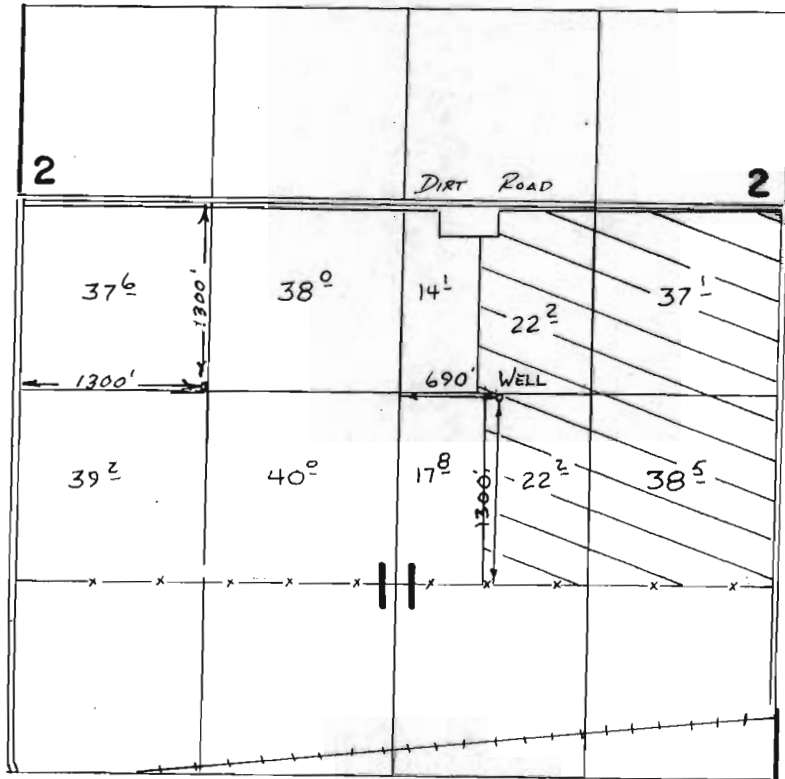

**FINAL PROOF SURVEY**  
UNDER

Application No. **G:9769** Permit No. **G:8980**  
IN NAME OF

**DVA**

Surveyed **5-7** 19**88**, by **V.L. Church**