


T.41S.,R.20E.W.M.

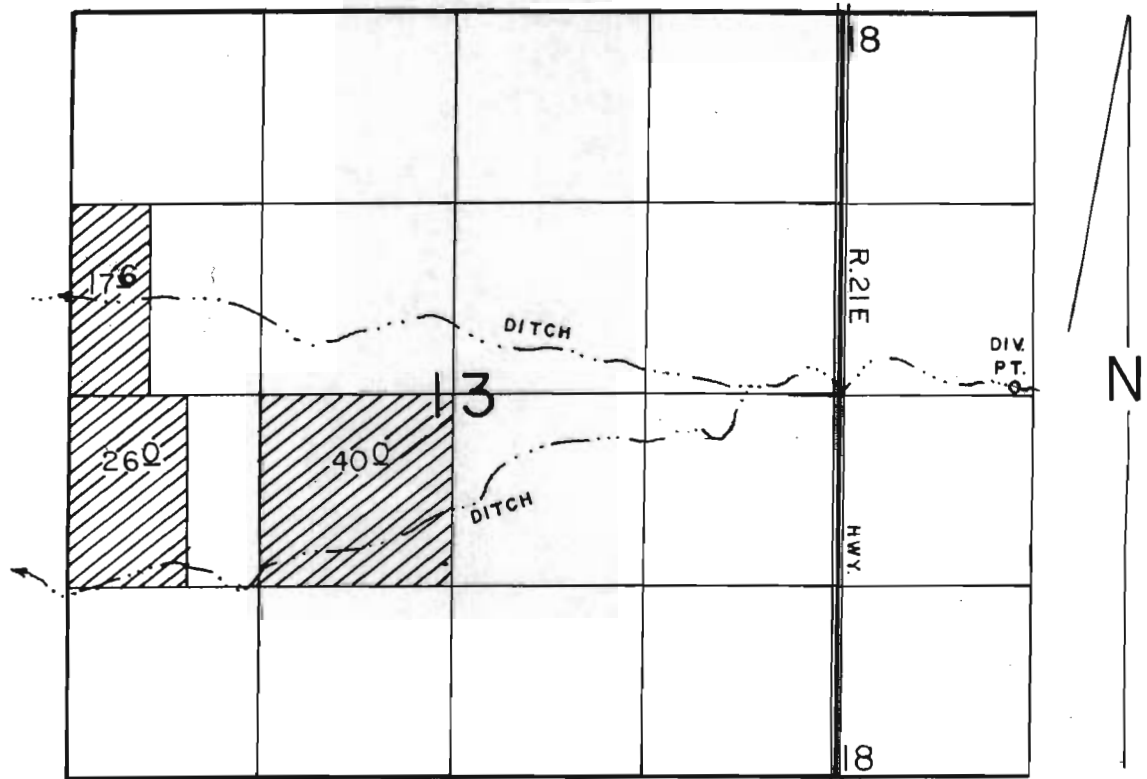

DIV.PT.LOC: 2680' N & 1200' E FROM SW COR. OF SEC 18.

SCALE: 1" = 1320'

FINAL PROOF SURVEY
UNDER

Application No. 67979. Permit No. 48328.....
IN NAME OF

KELLEY CREEK RANCH.....

Surveyed SEPT. 6. 19.94, by R.M.SUTTERFIELD