


# T. 41 S., R. 20 E., W.M.

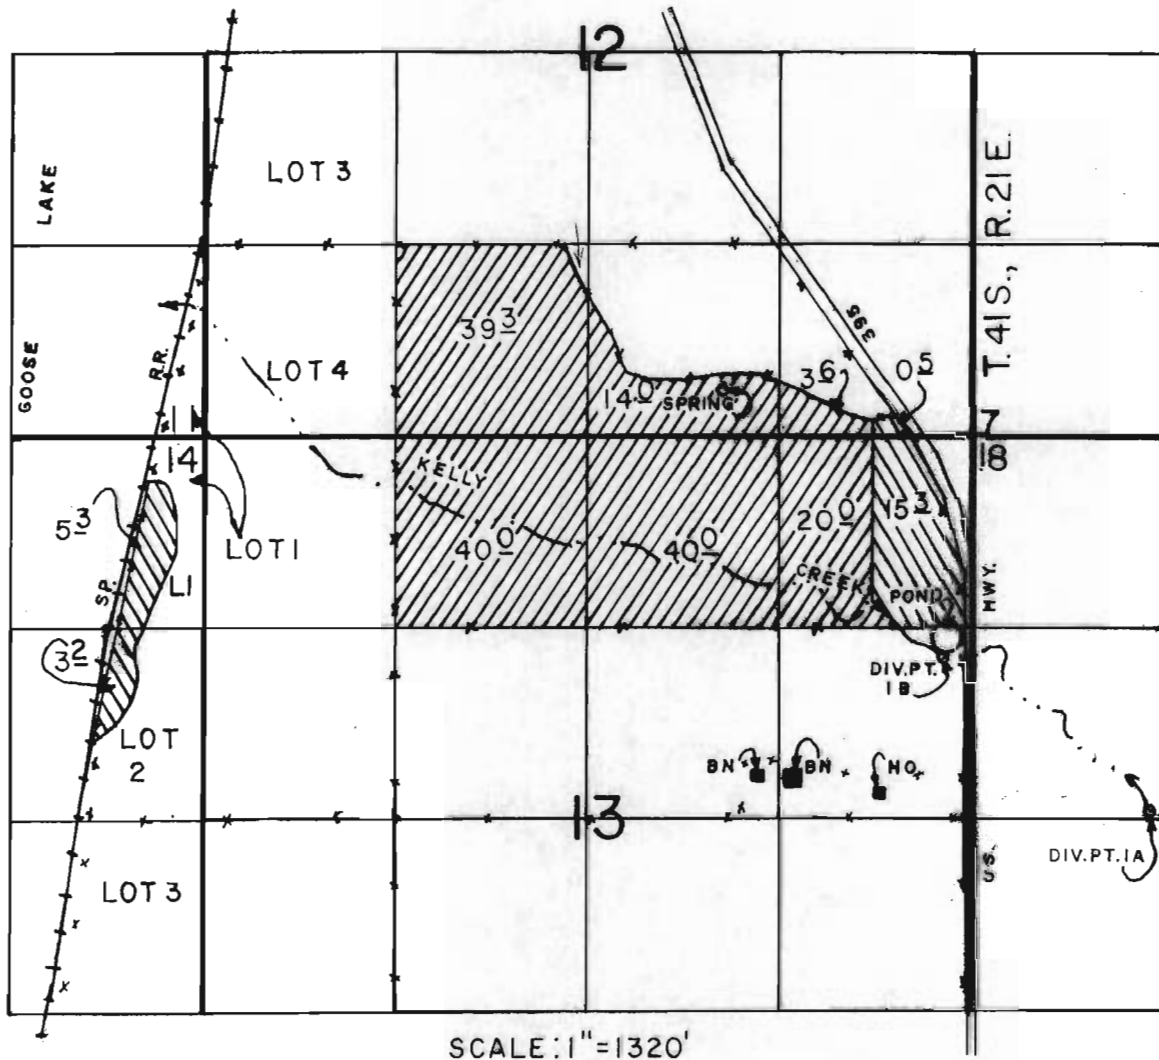

SCALE: 1"=1320'

DIV. PT. KELLY CREEK  
1A-2680' N & 1200' E FROM  
SW COR. OF SEC 18.

## FINAL PROOF SURVEY

UNDER

DIV. PT. KELLY CREEK  
1B-1100' N & 100' W FROM  
E 1/4 COR. OF SEC 13.

Application No. 68096 Permit No. 48831  
IN NAME OF

SPRING LOC: 310' N &  
1700' W FROM SE COR.  
OF SEC 12.

**LEWALLEN LAND AND CATTLE CO.**

Surveyed MARCH 21, 1994, by R.M. SUTTERFIELD

 PRIMARY  
 SUPPLEMENTAL