


T. 28 S. R. 14 & 15 E. W.M.

Application No. 68286
Permit No. 49350

All Ditches shown on this map
ARE POTENTIAL STOCK WATERING AREAS

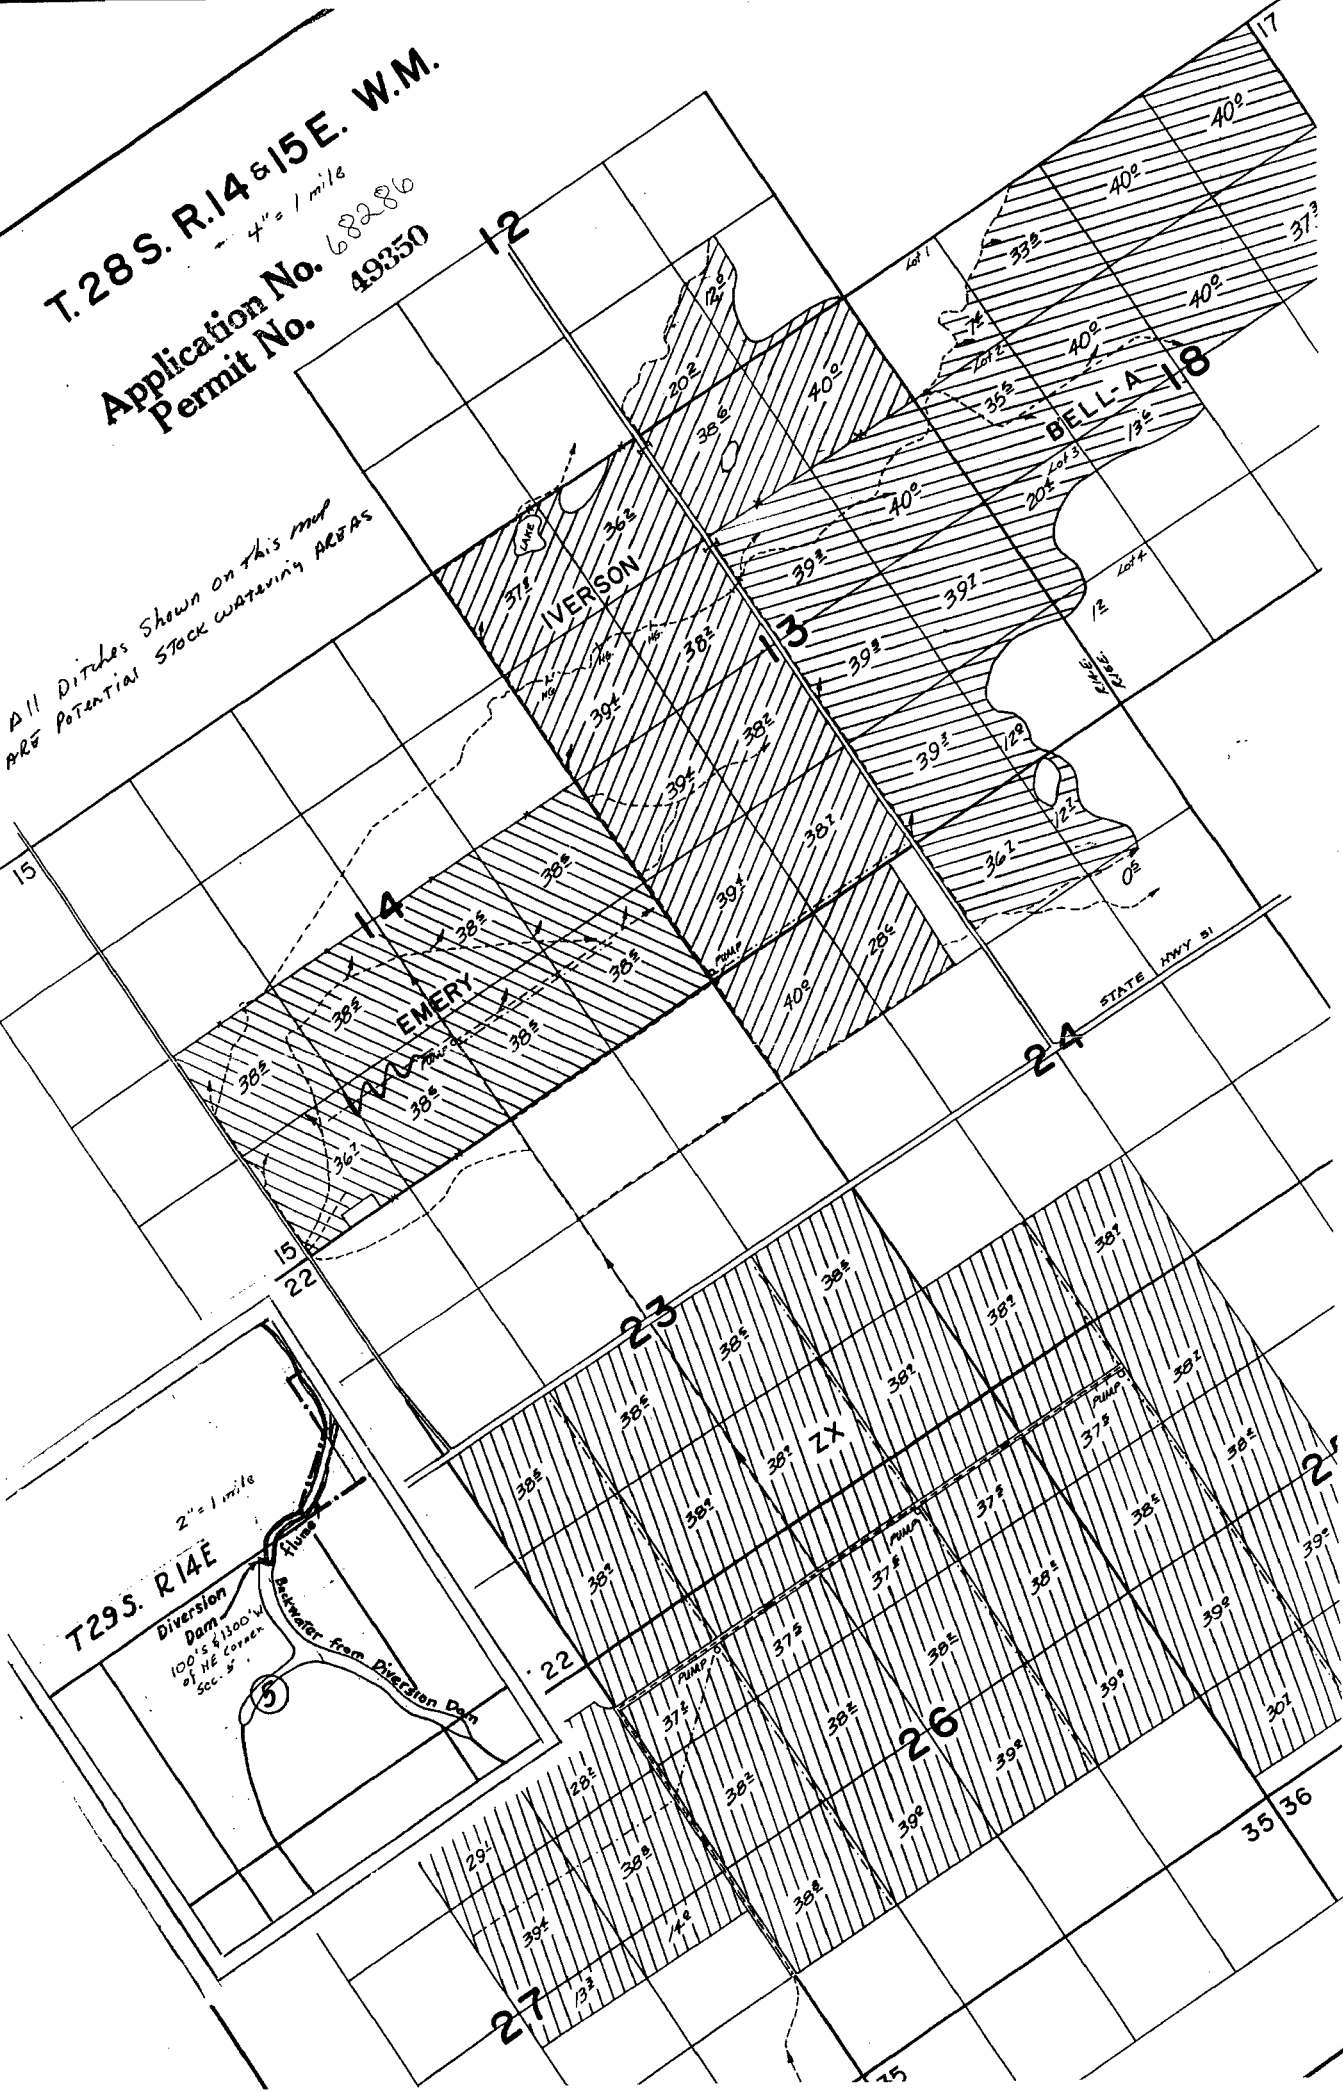

T. 29 S. R. 14 E

