


T. 8 S., R. 43 E., W.M.

RECEIVED

AUG - 4 1997

WATER RESOURCES DEPT.
SALEM, OREGON

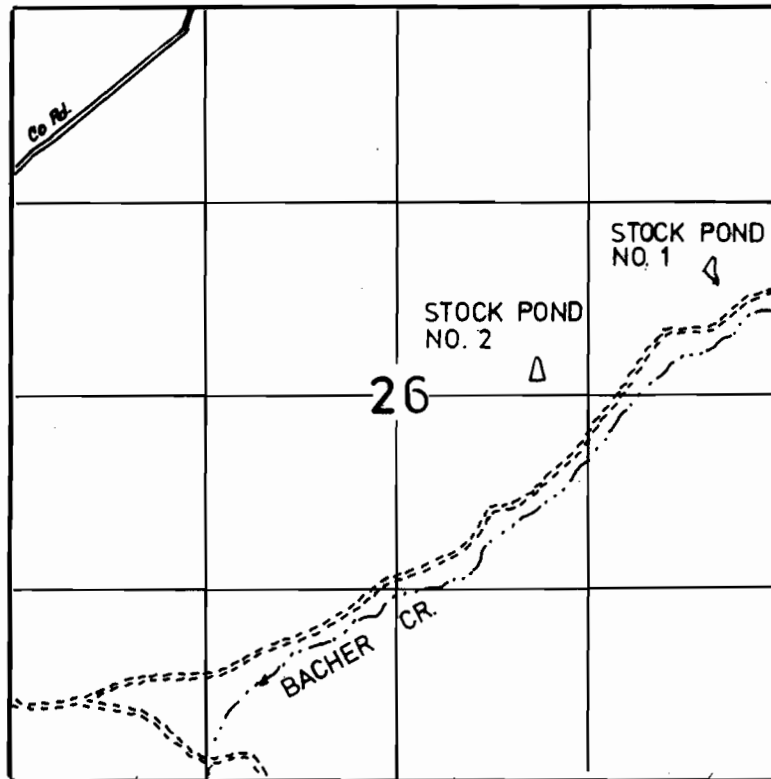

1" = 1320'

FINAL PROOF SURVEY

UNDER

Application No. R-64908 Permit No. R-8801
IN NAME OF

GEORGE PEARCE, JR.

Surveyed JULY 10, 1996, by J. MILLER