


TWP 8 S R 43 E WM

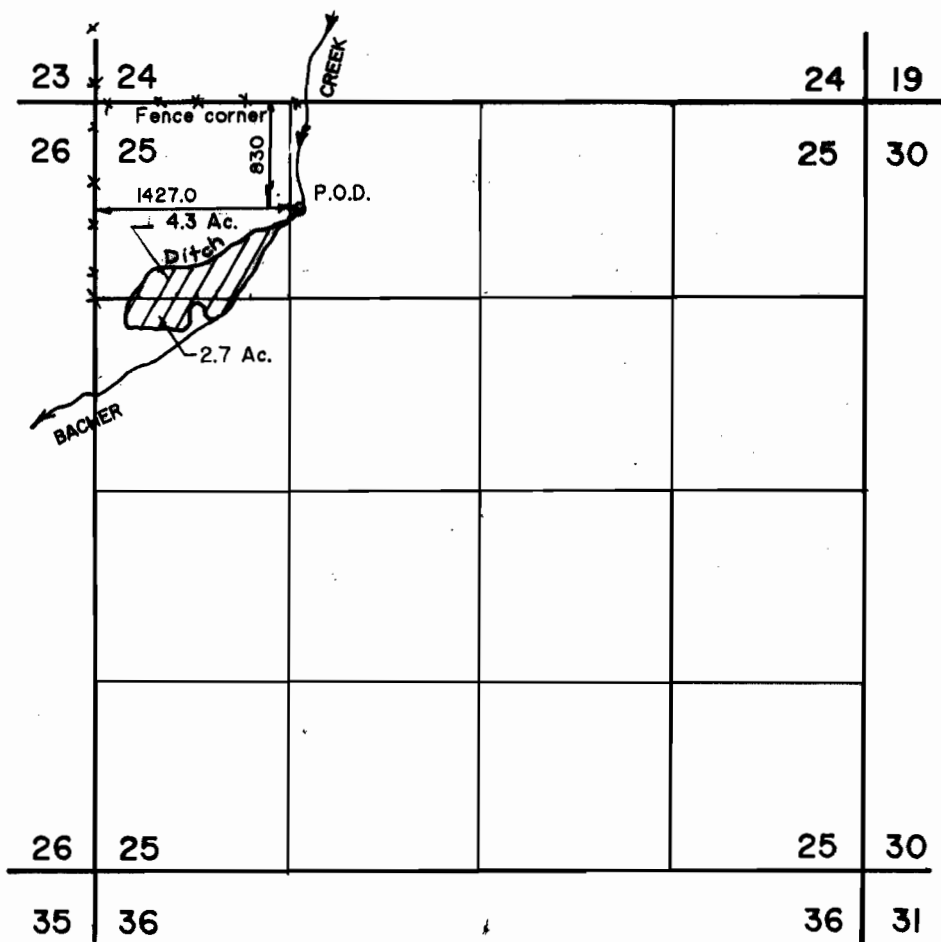

Point of Diversion is South
830' and East 1427' from the
Section corner.



SCALE 1" = 1320 Ft.

**FINAL PROOF SURVEY
UNDER
PERMIT NUMBER 47620**

FOR
GEORGE PEARCE

BY
BAGETT - GRIFFITH & ASSOC.,
P.O. BOX 576
LA GRANDE, OREGON 97850

