


A PORTION OF THE E 1/2, SECTION 22,
TOGETHER WITH A PORTION OF THE
W 1/2, SECTION 23, TOWNSHIP
18 SOUTH, RANGE 1 EAST, W.M.

CLAIM OF
BENEFICIAL USE MAP
SELLWOOD PARK
APPLICATION G-16341, PERMIT G-15814
IN THE NAME OF
THE CITY OF PORTLAND
PARKS AND RECREATION
SITUATED IN TAX LOT 300, SECTION 23,
T18, R1E, W.M., CITY OF PORTLAND
MULTNOMAH COUNTY, OREGON
SURVEY COMPLETED OCTOBER 28, 2005
BY DAN A. BUTTS, CURE

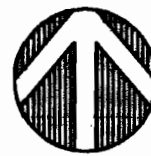


SCALE: 1"=400'

LEGEND:

- SECTION LINE
- 1/4 SECTION LINE
- PROPERTY LINE
- IRRIGATION MAINLINE
-  EXISTING IRRIGATED AREA FROM WELL AS PER PERMIT NO. G-15814 WITH GRASS LAWN (HATCHURE ANGLE CHANGES BY SECTIONAL SUBDIVISION)



EXPIRATION DATE: 12/31/07

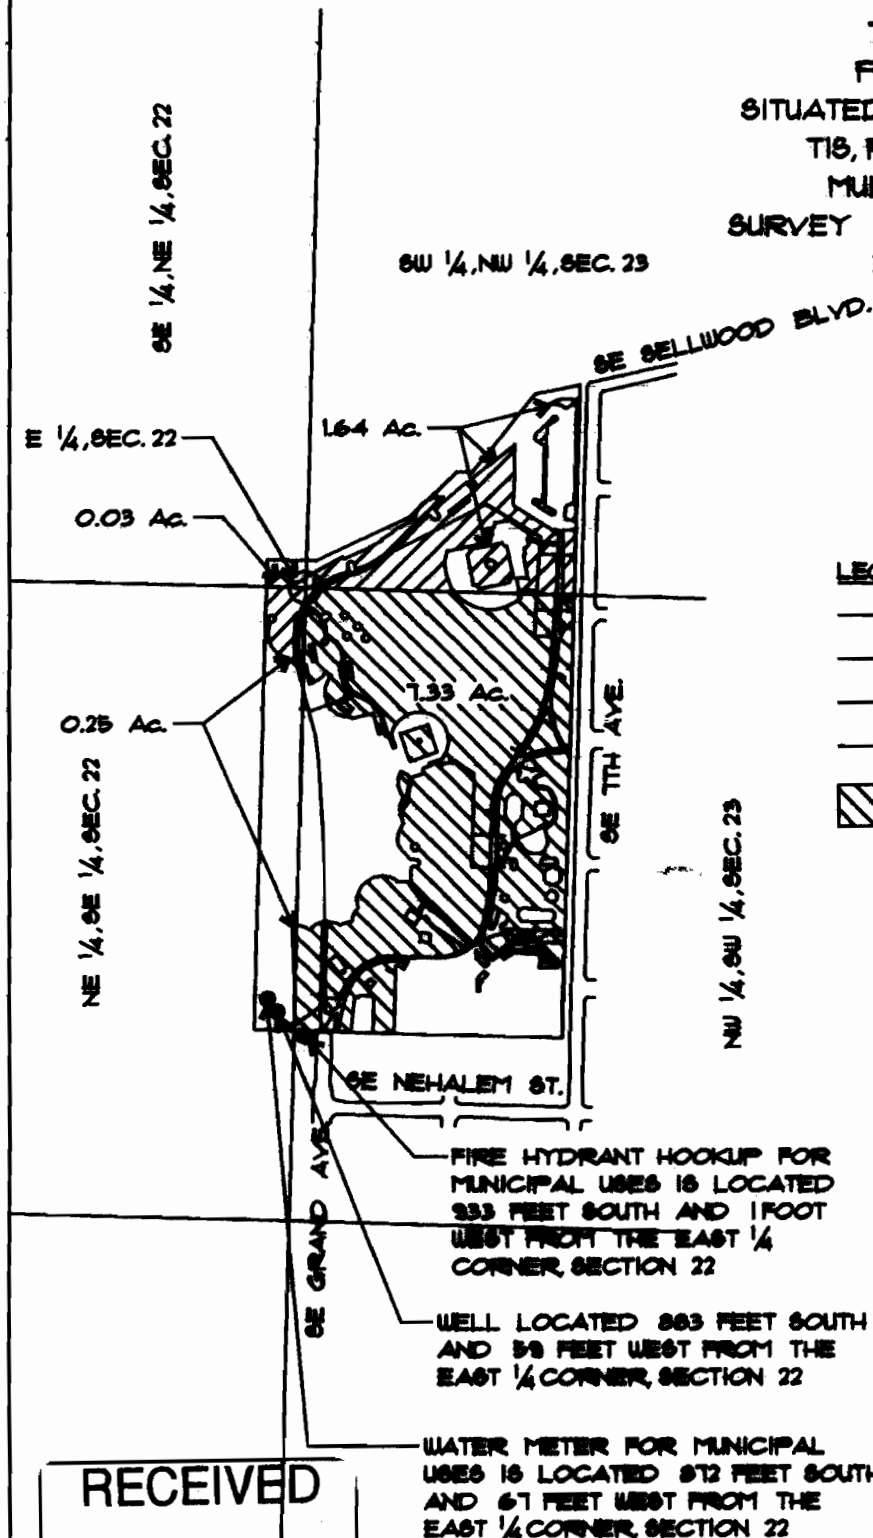

RECEIVED

SEP 13 2006

WATER RESOURCES DEPT
SALEM, OREGON

THIS MAP IS TO IDENTIFY A PROPOSED
WATER RIGHT LOCATION. IT IS NOT TO BE
USED TO LOCATE PROPERTY BOUNDARIES.