


T. 39 S., R. 19 E., W.M.

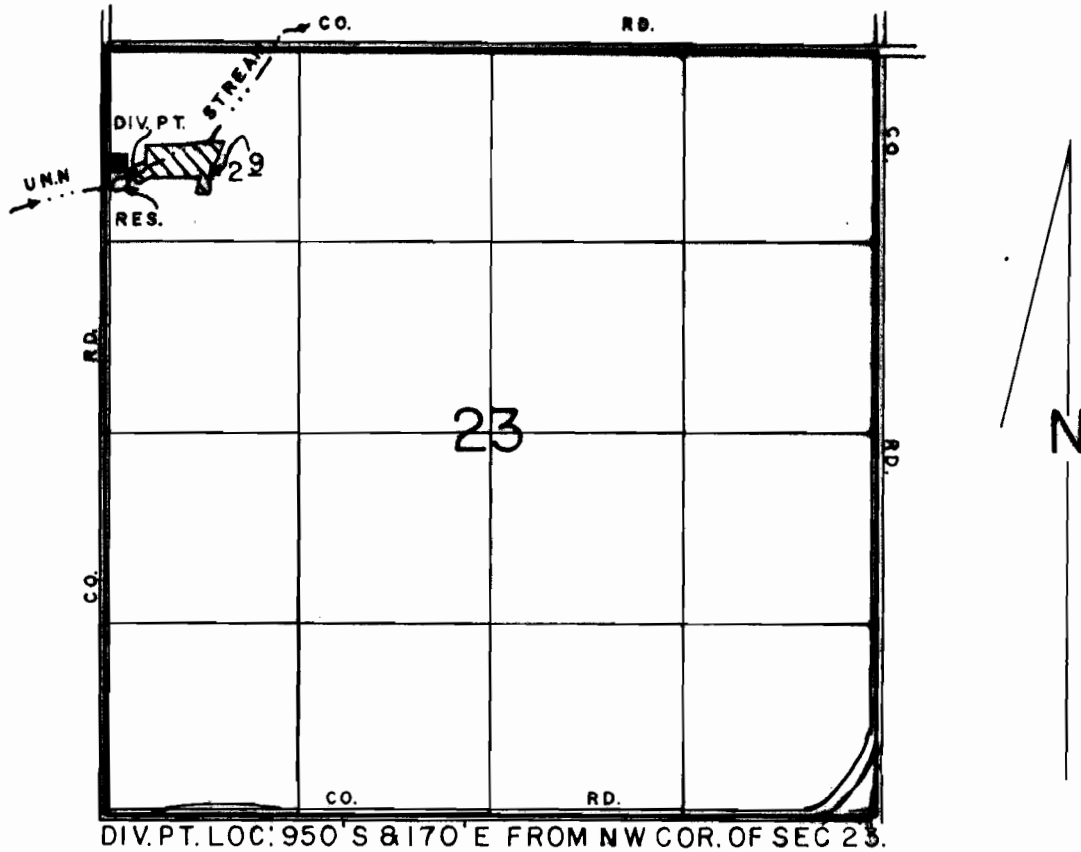

SCALE: 1" = 1320'

FINAL PROOF SURVEY

UNDER

R-55929

R-6623

Application No. 55930 Permit No. 41929

IN NAME OF

WILLIAM H. ROGERS AND LOIS F. ROGERS

Surveyed OCT 16, 1987, by T.M. WARREN