


T. 1 N., R. 2 W., W. M.

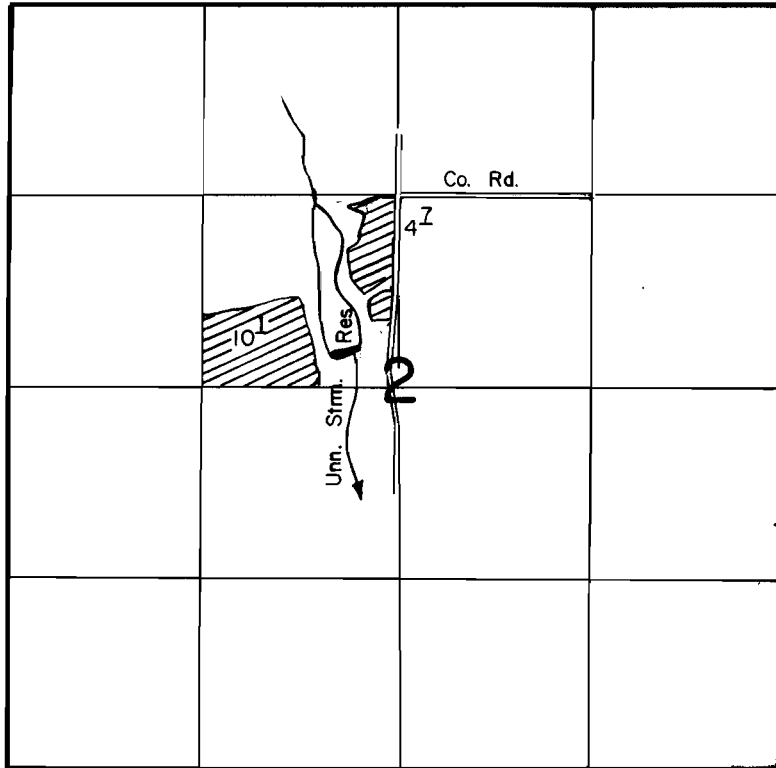

Scale : 1" = 1320'

# FINAL PROOF SURVEY

UNDER

TRANSFER 3484

Application No. .... Permit No. ....  
IN NAME OF

..... FRED BENDER .....

Surveyed March 31, 1988., by J. Warren.....

44067-178-156 B  
1/27/89 TFW