


T. 13 S., R. 28 E., W.M.

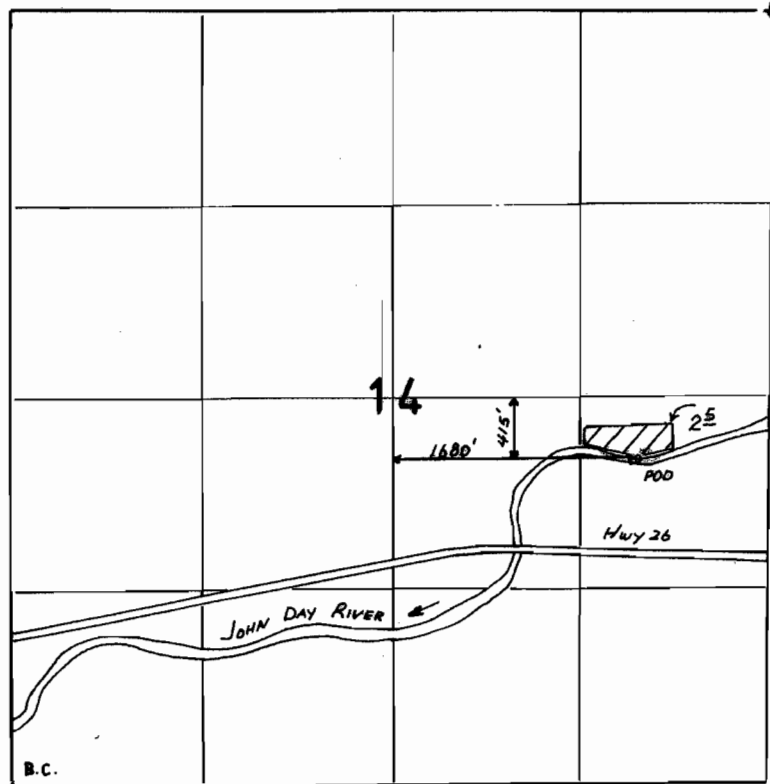

1" = 1320'

FINAL PROOF SURVEY

UNDER
TRANSFER 3746
IN NAME OF

HANS C. AND MARY B. ESKILDSON

Surveyed AUGUST 14, 1991, by I. MILLER

RECEIVED

MAY - 2 1996

WATER RESOURCES DEPT.
SALEM, OREGON