


T. 25S., R. 4 W., W.M.

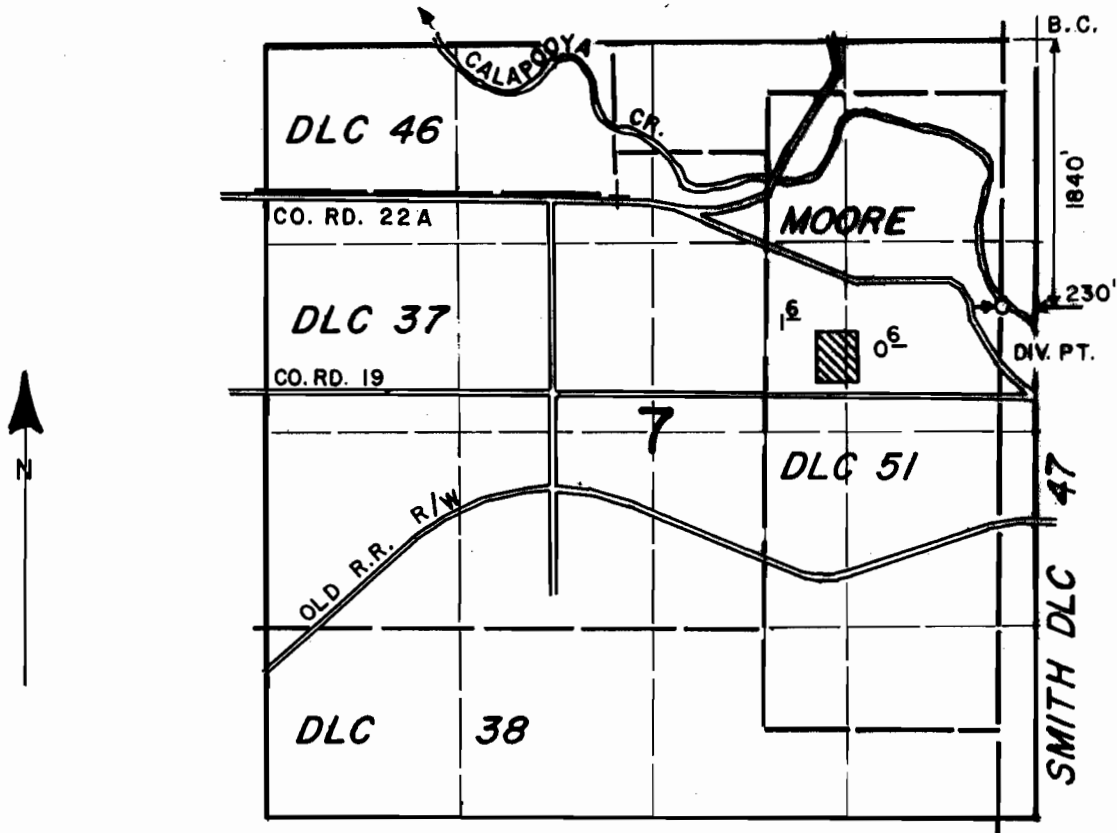

SCALE: 4" = 1 MILE

FINAL PROOF SURVEY
UNDER

TRANSFER NUMBER: 4494
Application No. Permit No.
IN NAME OF

..... **ROBERT C. DAVIS**

Surveyed JUNE 9, 1987, by J. M. SCHMORDE.