


T. 14S. R. 45E.W.M.

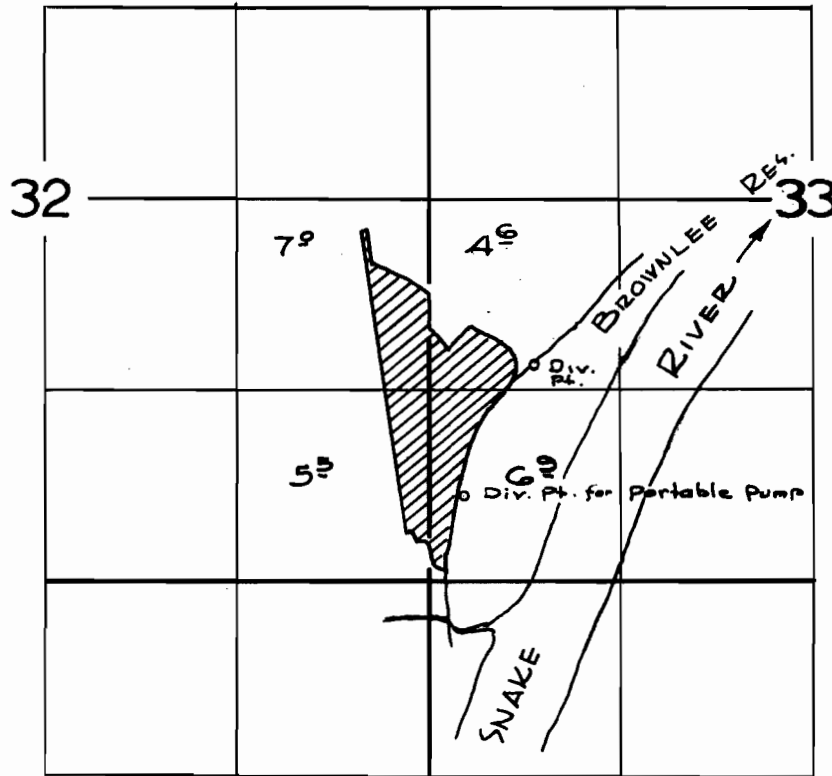

FINAL PROOF SURVEY
UNDER

Application No. 33010 Permit No. 26100
IN NAME OF

OREGON STATE HIGHWAY COMMISSION

Surveyed Mar. 16, 1964 by D.B. Hall

RECEIVED

STATE OF OREGON
DEPARTMENT OF TRANSPORTATION