


T. 34S., R. 8E., W.M.

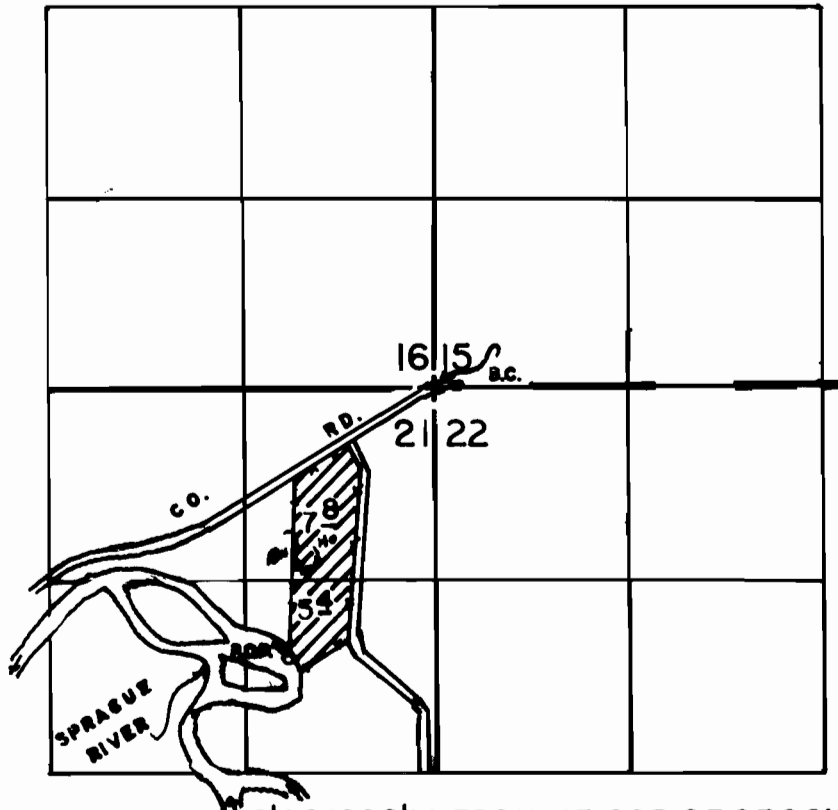

P.O.D. LOC: 1850'S & 1000' W FROM NE COR. OF SEC 21.

SCALE: 1" = 1320'

FINAL PROOF SURVEY

UNDER

Application No. 56013 Permit No. 42355
IN NAME OF

RICHARD OUTCALT

Surveyed MAY 25, 1994, by R.M.SUTTERFIELD